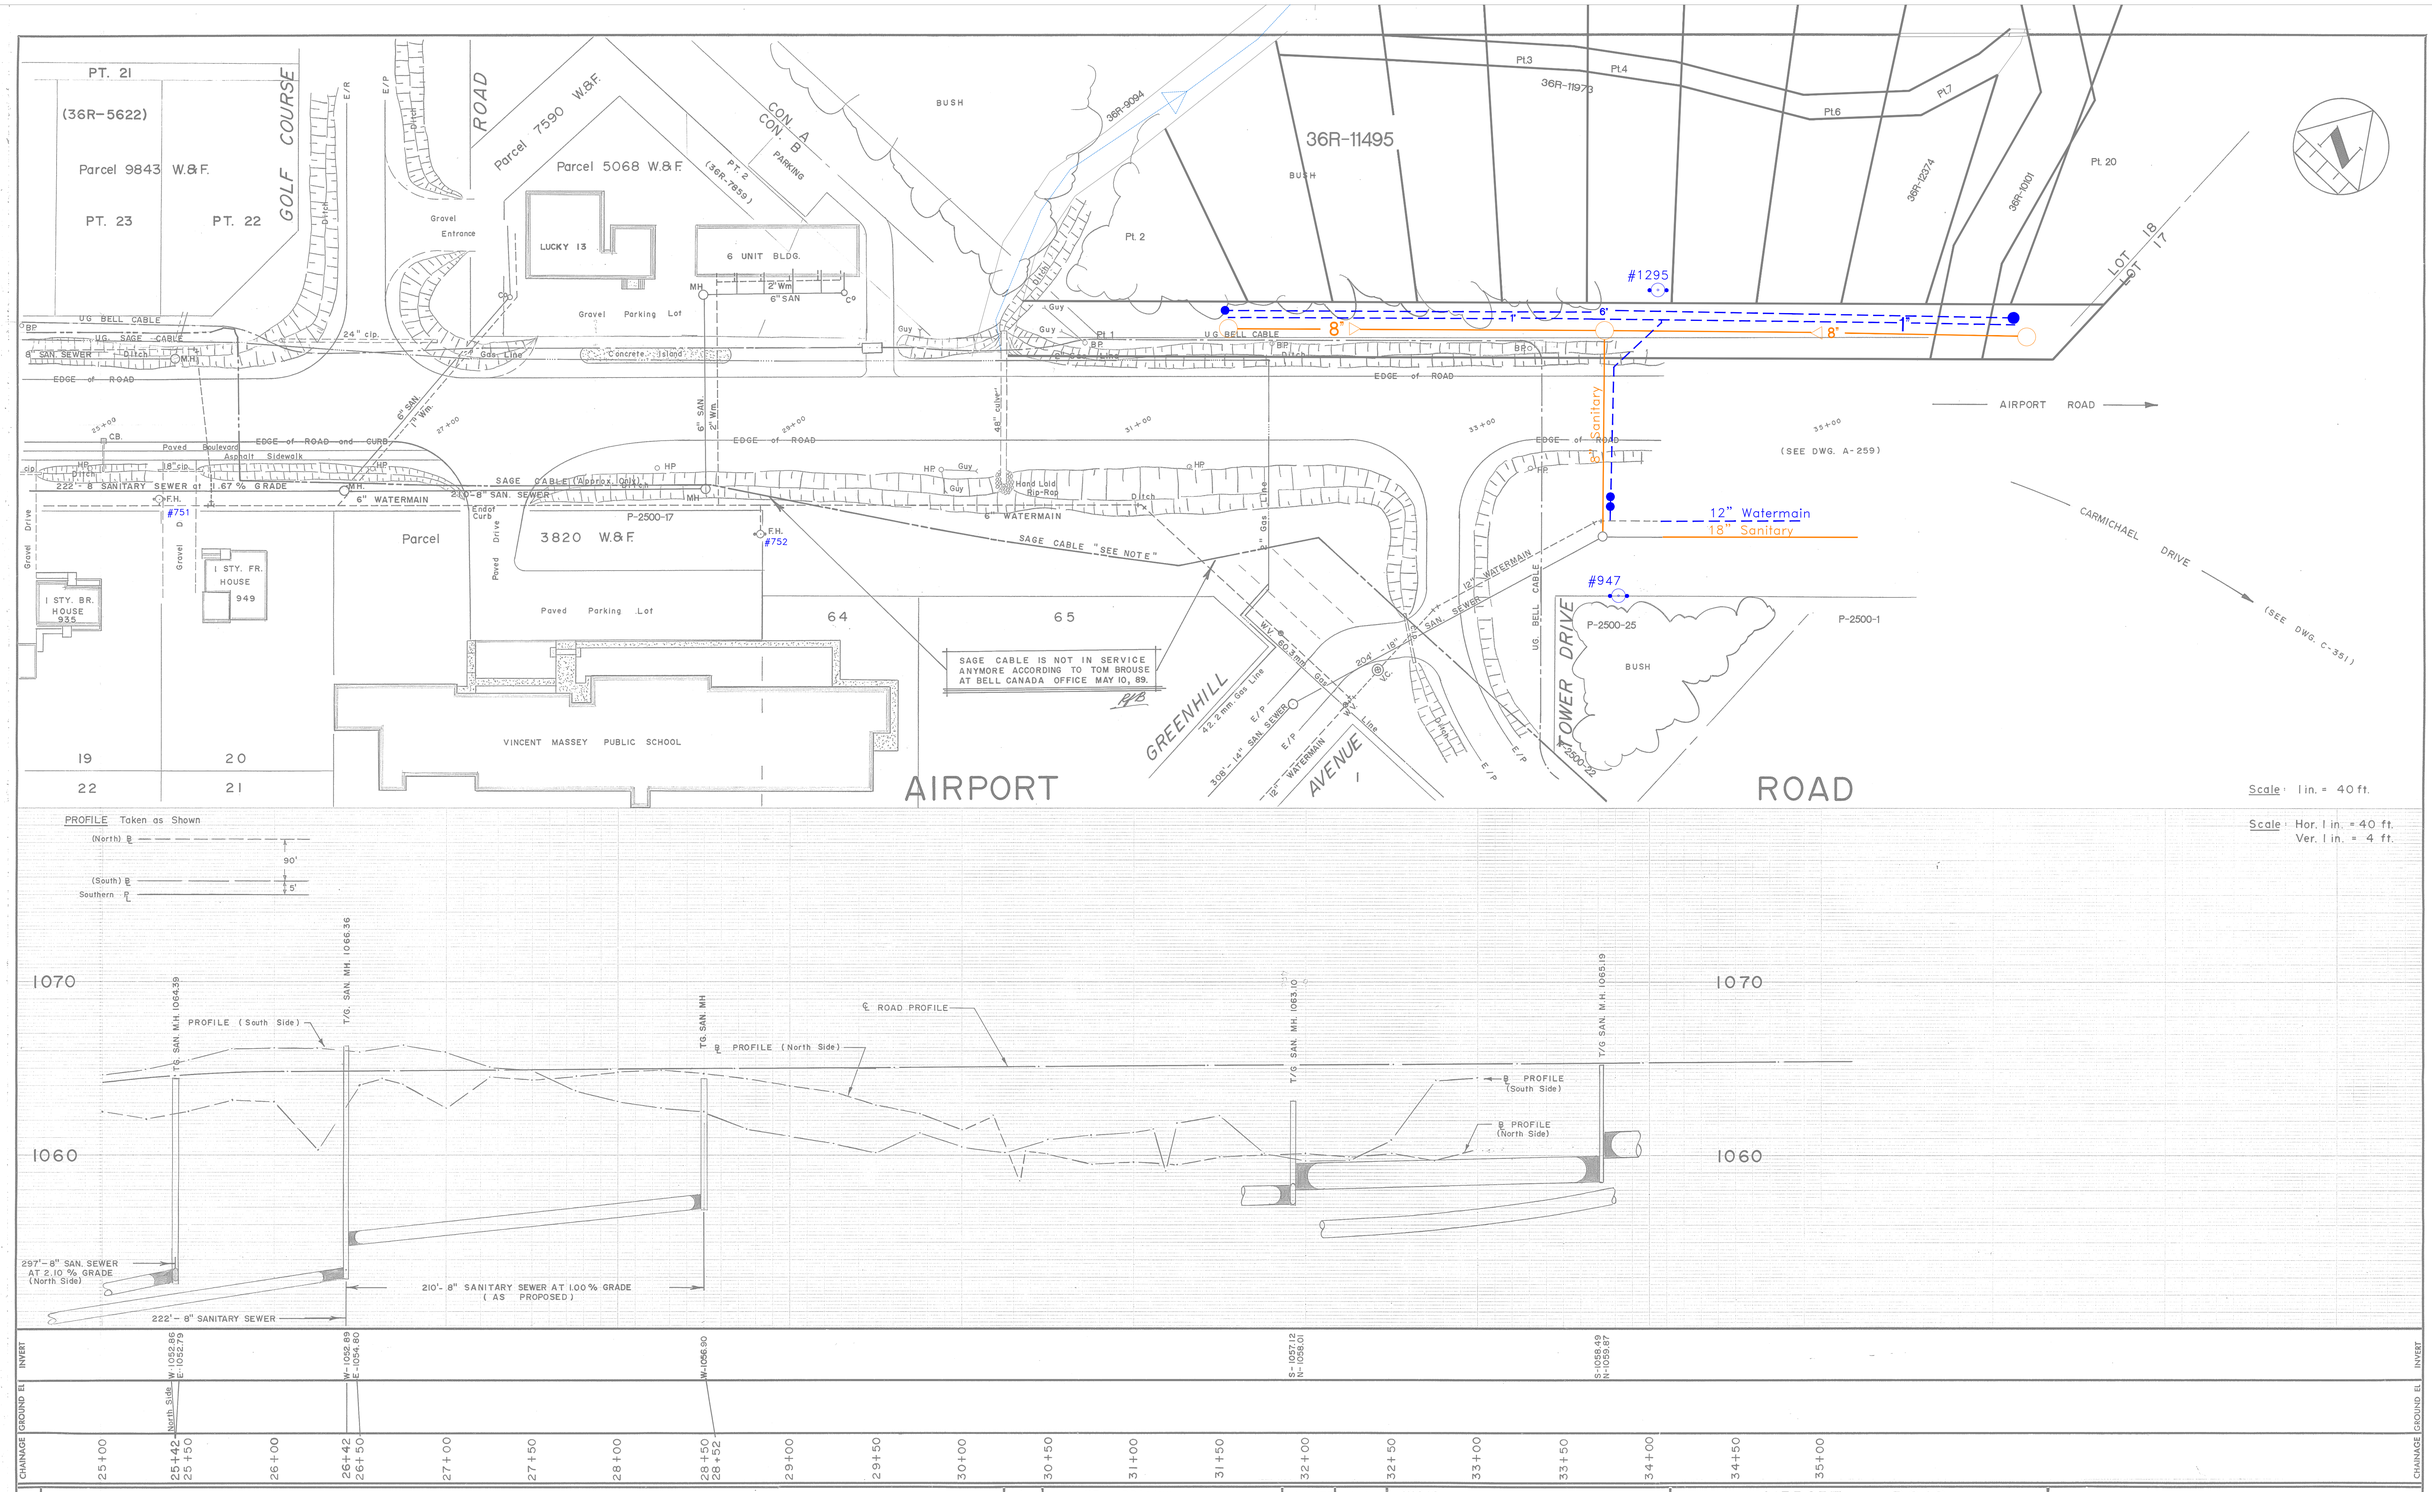

NOTES:

DWG. No.

DISCLAIMER

The information contained on this drawing may be based upon data provided by others and may not have been verified by either as-constructed drawings or an Ontario Land Surveyor. The City of North Bay cannot accept responsibility for any errors or omissions on any information shown herein. Field verification, land surveys or excavation (with City approvals) may be required to determine actual location of any and all utilities or property lines.

No.	REVISION	DATE	INITIAL
1.	NEW DRAWING	June/75	J.d.M.
2.	AS CONS'T SANITARY & WATERMAIN	Mar./77	j.d.m.
3.	NEW HYDRO LINE	JULY 78	j.d.m.
4.	AS CONST. SAN. SEWER (North Side)	AUG. 83	J.S.
5.	ROAD PROFILE ADDED AS SHOWN ON M.T.C. CONT. No. 66-219	MAR. '87	P.L.C.
6.	ADDITION OF GAS LINE.	MAY '87	A.P.
7	AS CONST. SAN, Wm. LUCKY 13 & APT. BLDG.	APRIL/94	RT

APPROVED

NORTH BAY ONTARIO CANADA
Just North Enough to be PERFECT

AIRPORT ROAD
GOLF COURSE ROAD to TOWER DRIVE

REG'D PLAN No. M-270, M-285
M-285, Lot 18, Con.B.
36R-5622

CITY OF NORTH BAY
ENGINEERING DEPARTMENT

SCALE: AS SHOWN
DATE: JUNE, 1975

DRAWN BY: JM
CK'D. BY:
FIELD BOOK No. 242
DRAWING No. A-258
REV.