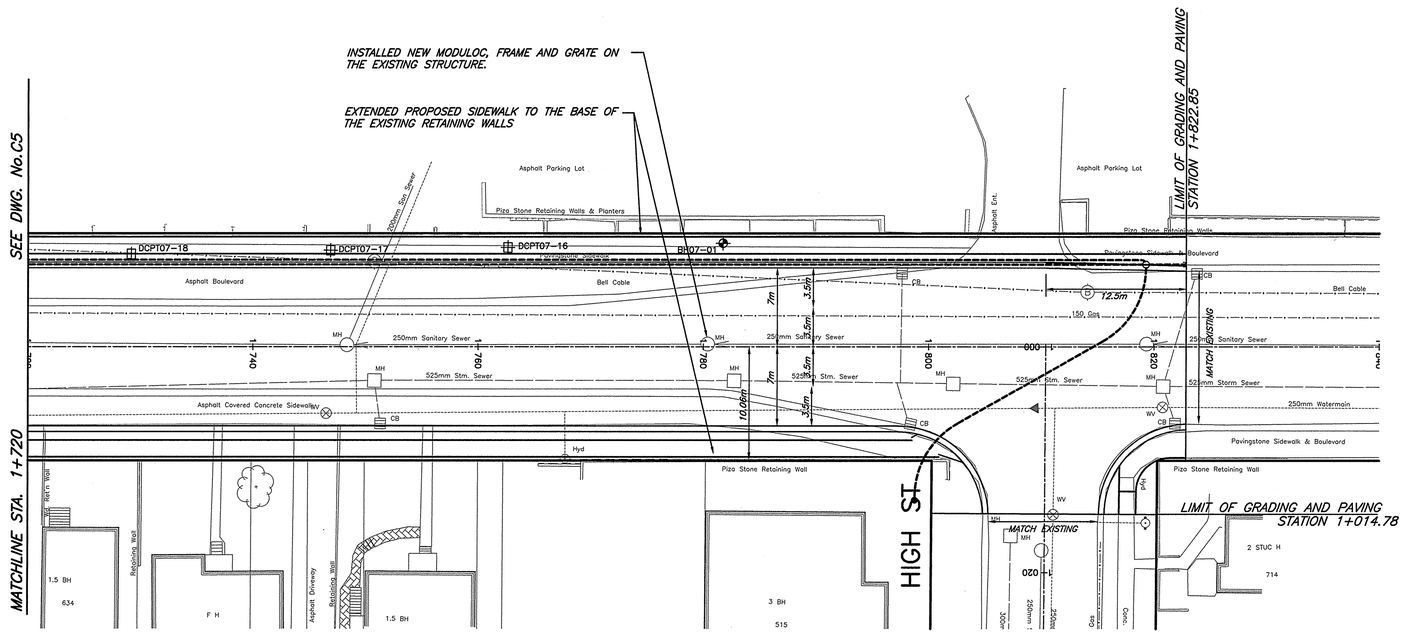

ALGONQUIN AVENUE

FOR GENERAL NOTES SEE DWG. 1

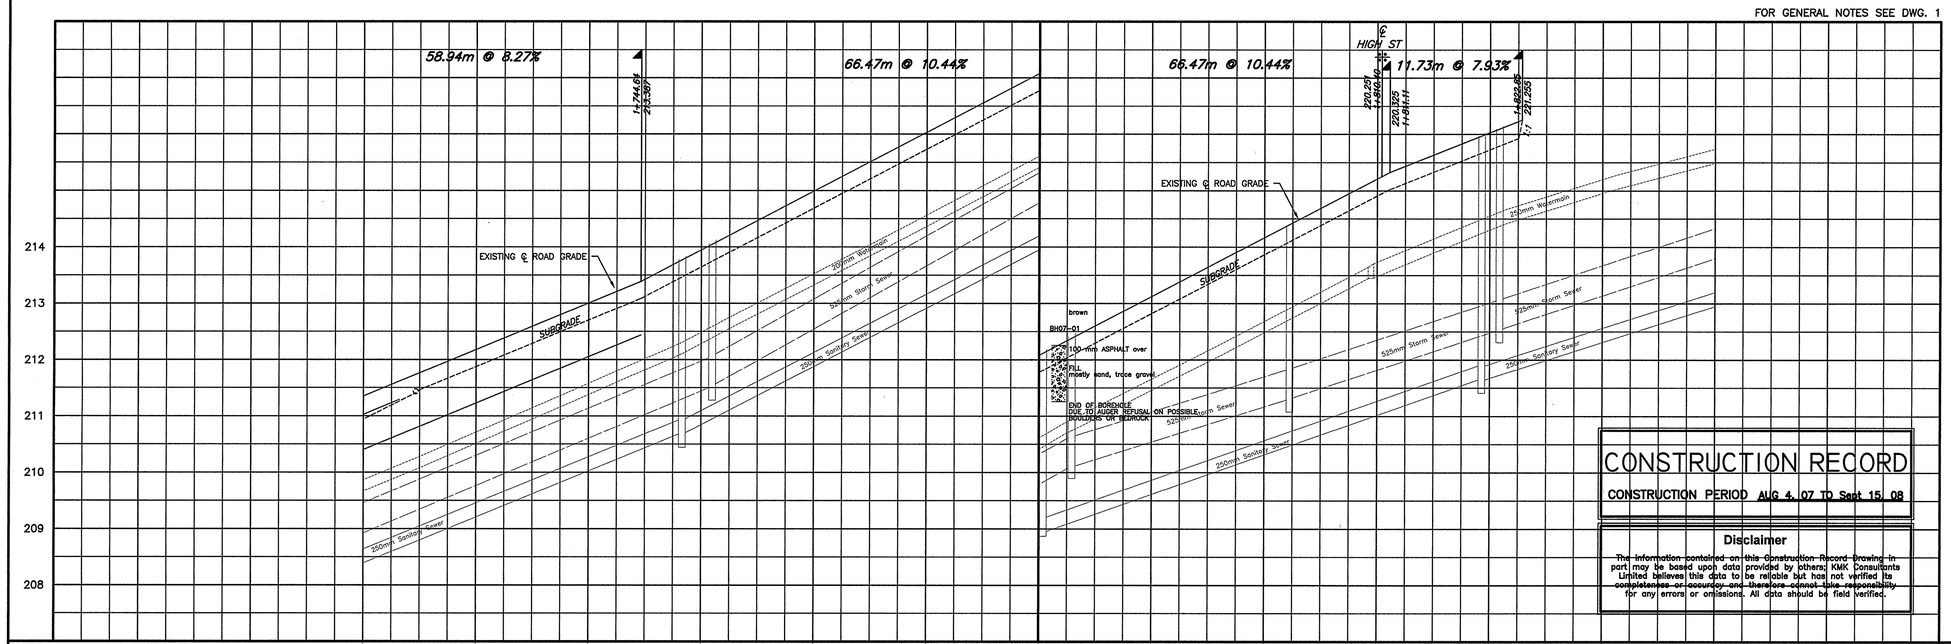

CONSTRUCTION RECORD

CONSTRUCTION PERIOD AUG 4, 07 TO Sept 15, 08

Disclaimer

The information contained on this Construction Record Drawing in part may be based upon data provided by others; KMK Consultants Limited believes this data to be reliable but has not verified its completeness or accuracy and therefore cannot take responsibility for any errors or omissions. All data should be field verified.

℄ ROAD ELEVATION	211.350		213.004		214.991		217.078	217.078	219.165	221.030	
STORM INVERT											
SANITARY INVERT											
℄ ROAD CHAINAGE	1+720		1+740		1+760		1+780	1+780	1+800	1+820	1+840

2862-A-14

designer	drawn by:
G.Mc	G.Mc.
checked by:	approved by:
B.M.	D.D.

revisions

no.	date	by	description
1	12 MAY 2007	G.Mc.	ISSUED FOR TENDER
2	6 APR 2009	R.H.	AS CONSTRUCTED

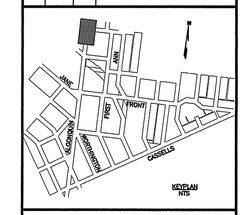

The Corporation of the City of North Bay

Tender 2007 – 61
Contract No. 1

Algonquin Avenue and Area Road Reconstruction–Phase 1

ORIGINAL SIGNED BY:
D.R. DIETRICH
DATED MAY 10 2007

CONSTRUCTION

ALGONQUIN AVE
STA. 1+720 TO STA. 1+820

KMK Consultants Limited

scale
H. 1:250
V. 1:50

file reference: 2862-A-14
drawing number: A-78C
date: FEB 2007
sheet number: 18 of 33