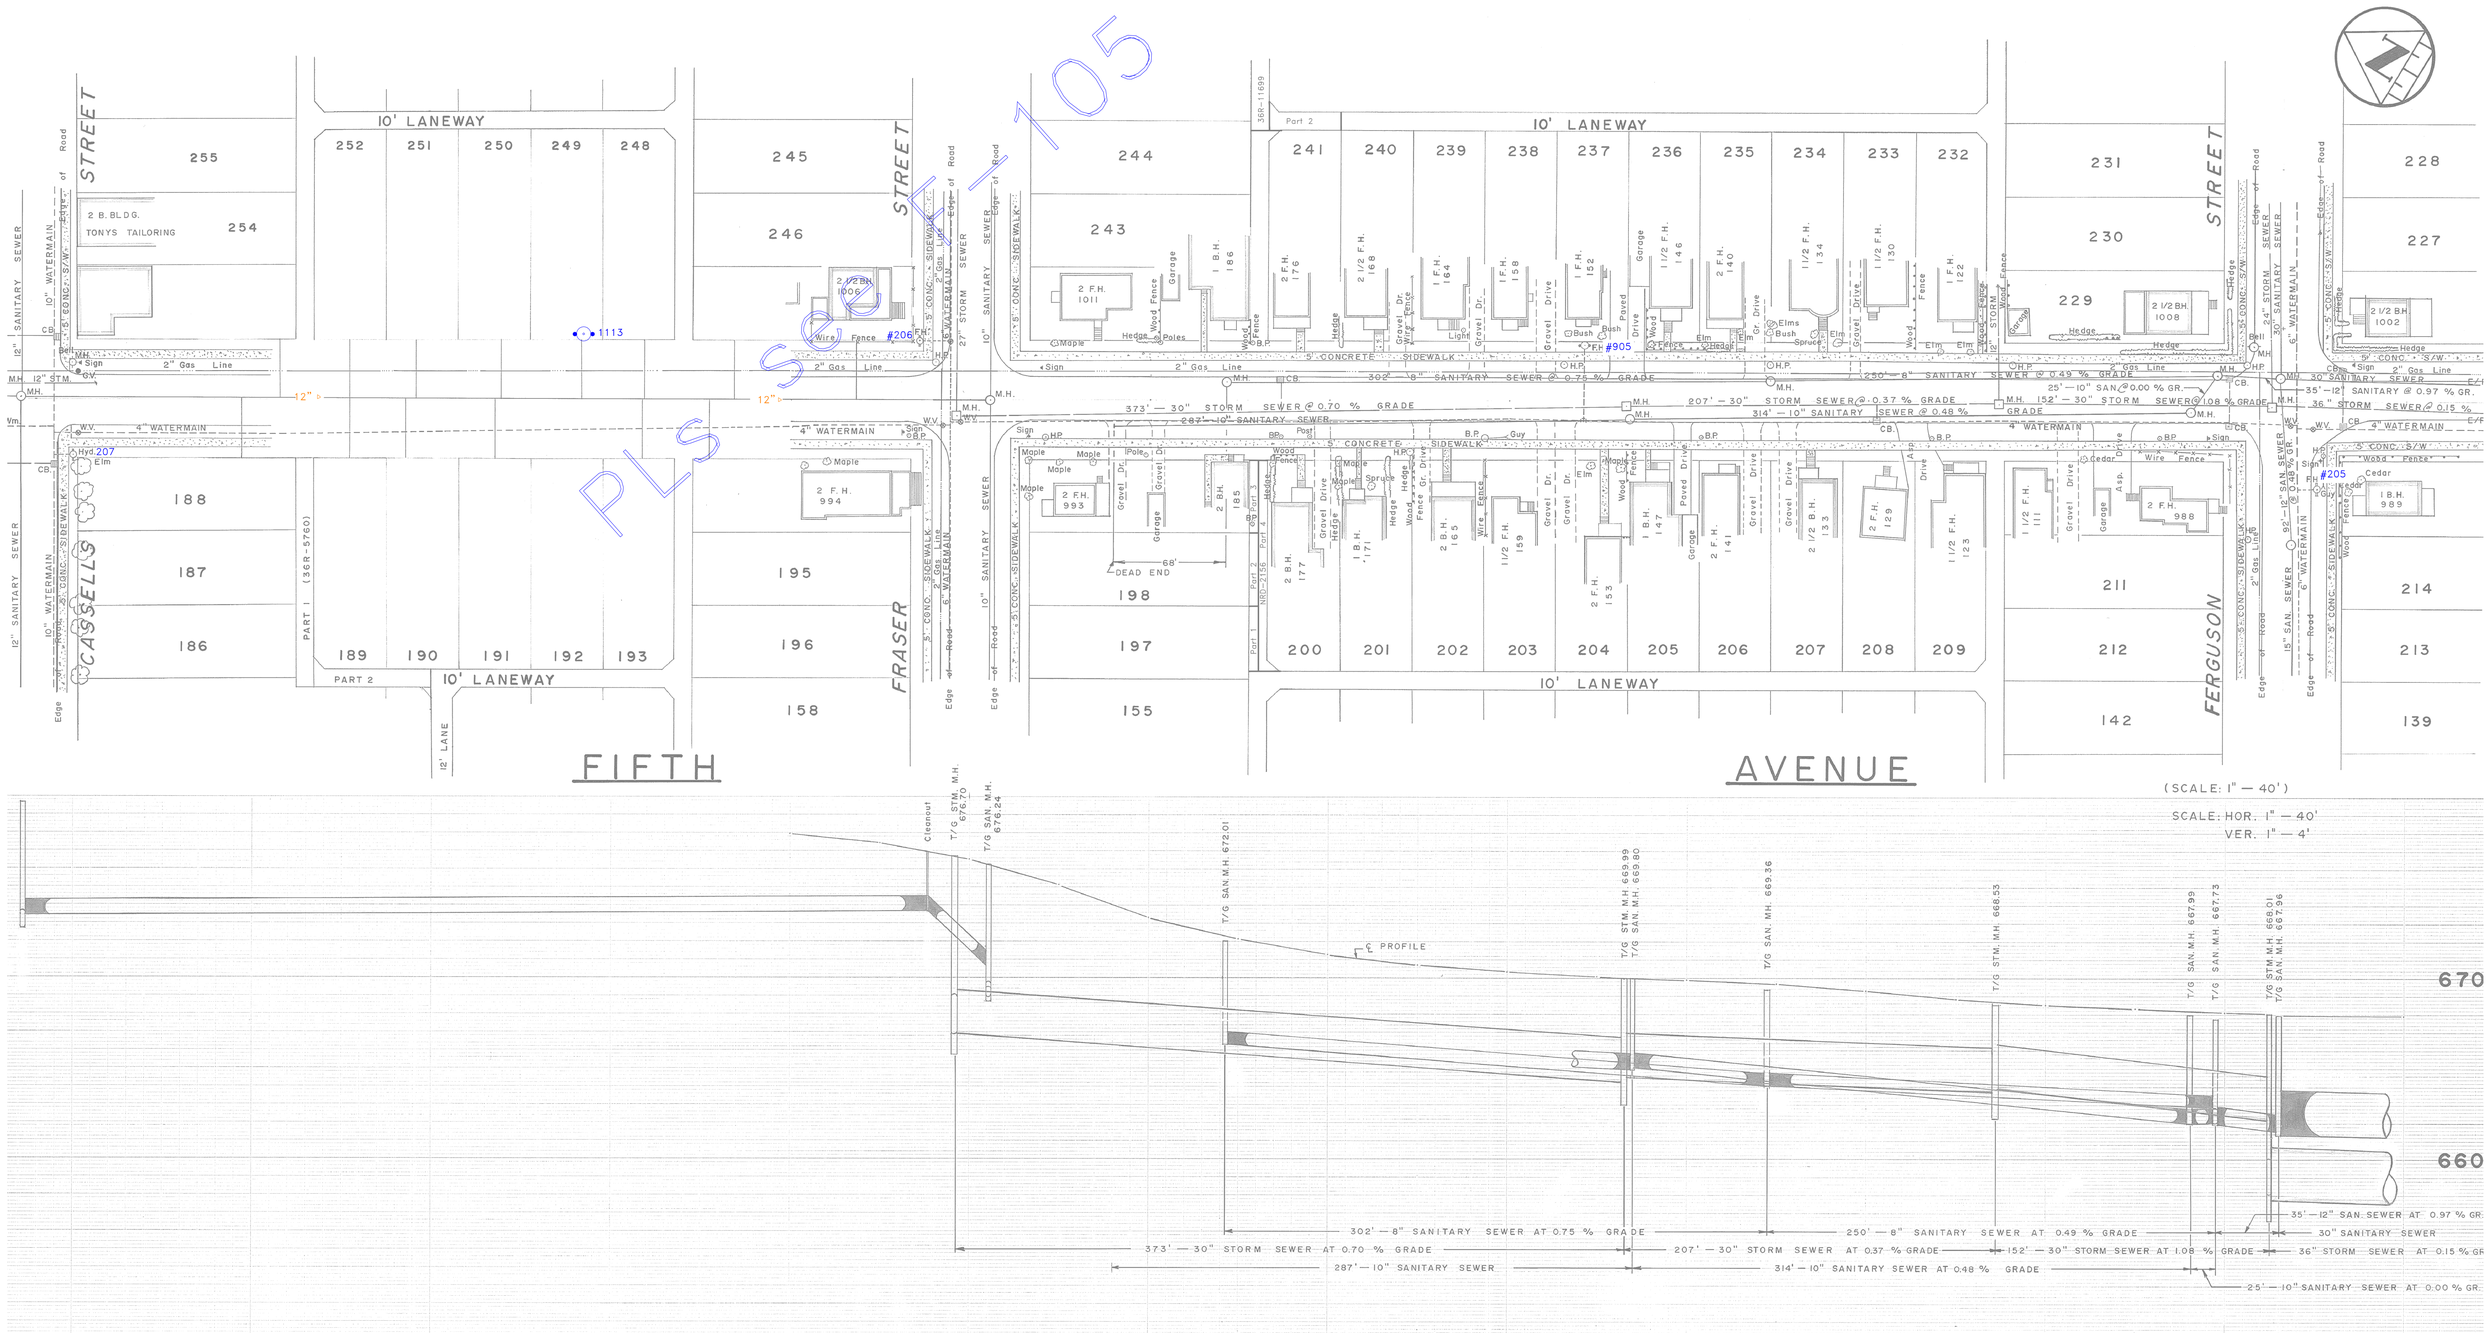

NOTES:

DISCLAIMER

The information contained on this drawing may be based upon data provided by others and may not have been verified by either as-constructed drawings or an Ontario Land Surveyor. The City of North Bay cannot accept responsibility for any errors or omissions on any information shown herein. Field verification, land surveys or excavation (with City approvals) may be required to determine actual location of any and all utilities or property lines.

NORTH BAY — Just North Enough to be POPULAR

No.	REVISION	DATE	INITIAL
1.	NEW DRAWING FROM 1973 FIELD BK.225	MAY 81	A.P.
2.	Added NRD-2156, 36R-11699	May 2015	G.W.C.

APPROVED

FIFTH AVENUE
CASSELLS ST. TO FERGUSON ST.
REG'D PLAN Nº. 62,54,48.

CITY OF NORTH BAY
ENGINEERING DEPARTMENT

SCALE: AS SHOWN — DATE: MAY / 81

DRAWN BY: A.P. — CK'D. BY: — FIELD BOOK No. 225 — DRAWING No. F-102 — REV.