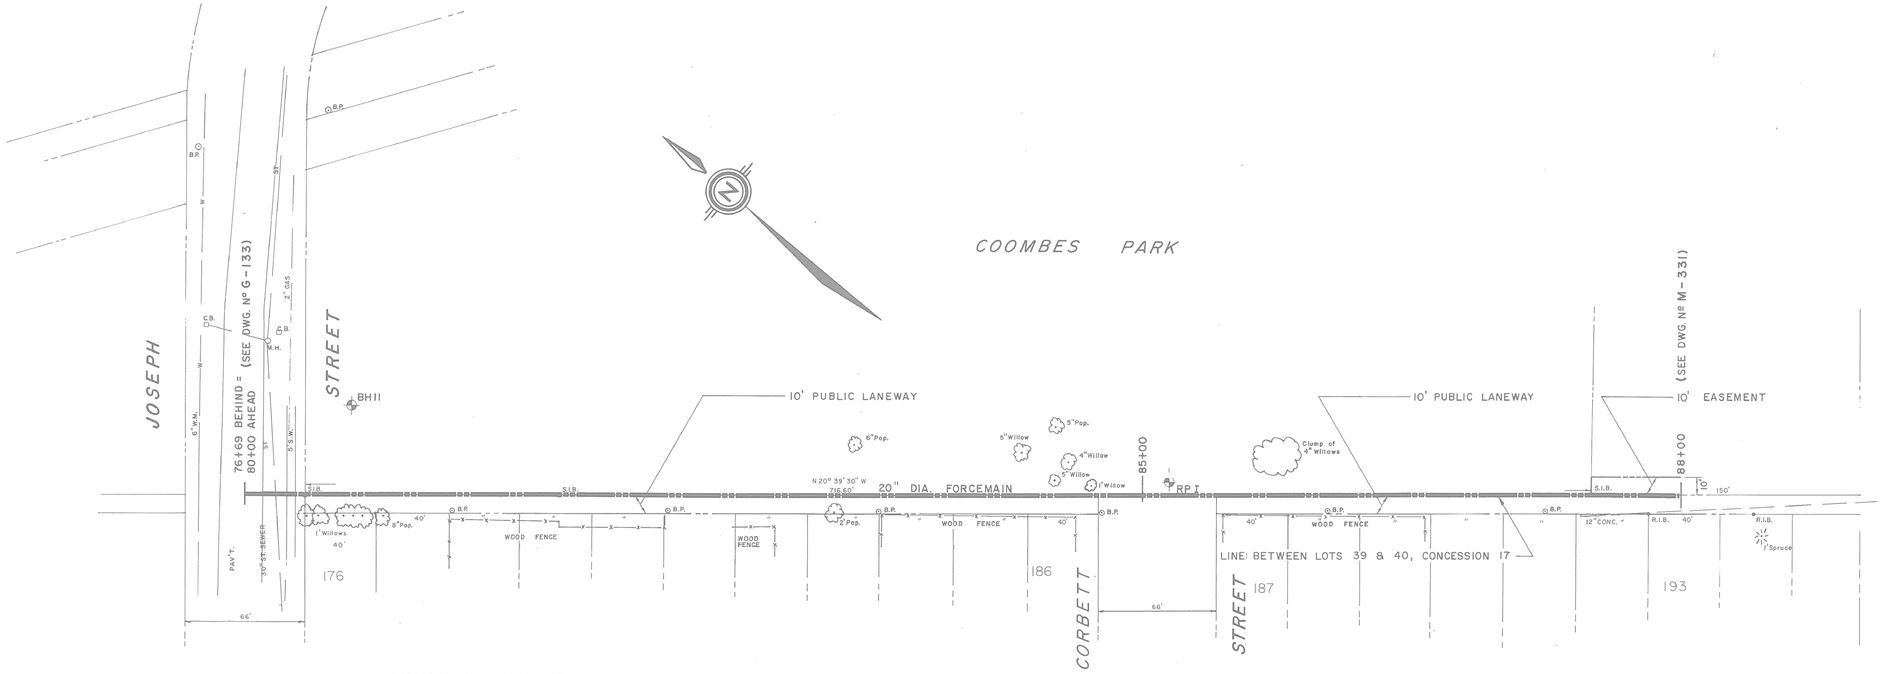

BM CUT CROSS ON CONC. BASE OF WEST BRICK GATE PILLAR AT THE NEW APOSTOLIC CHURCH ON JOSEPH ST.

ELEV. 648.75

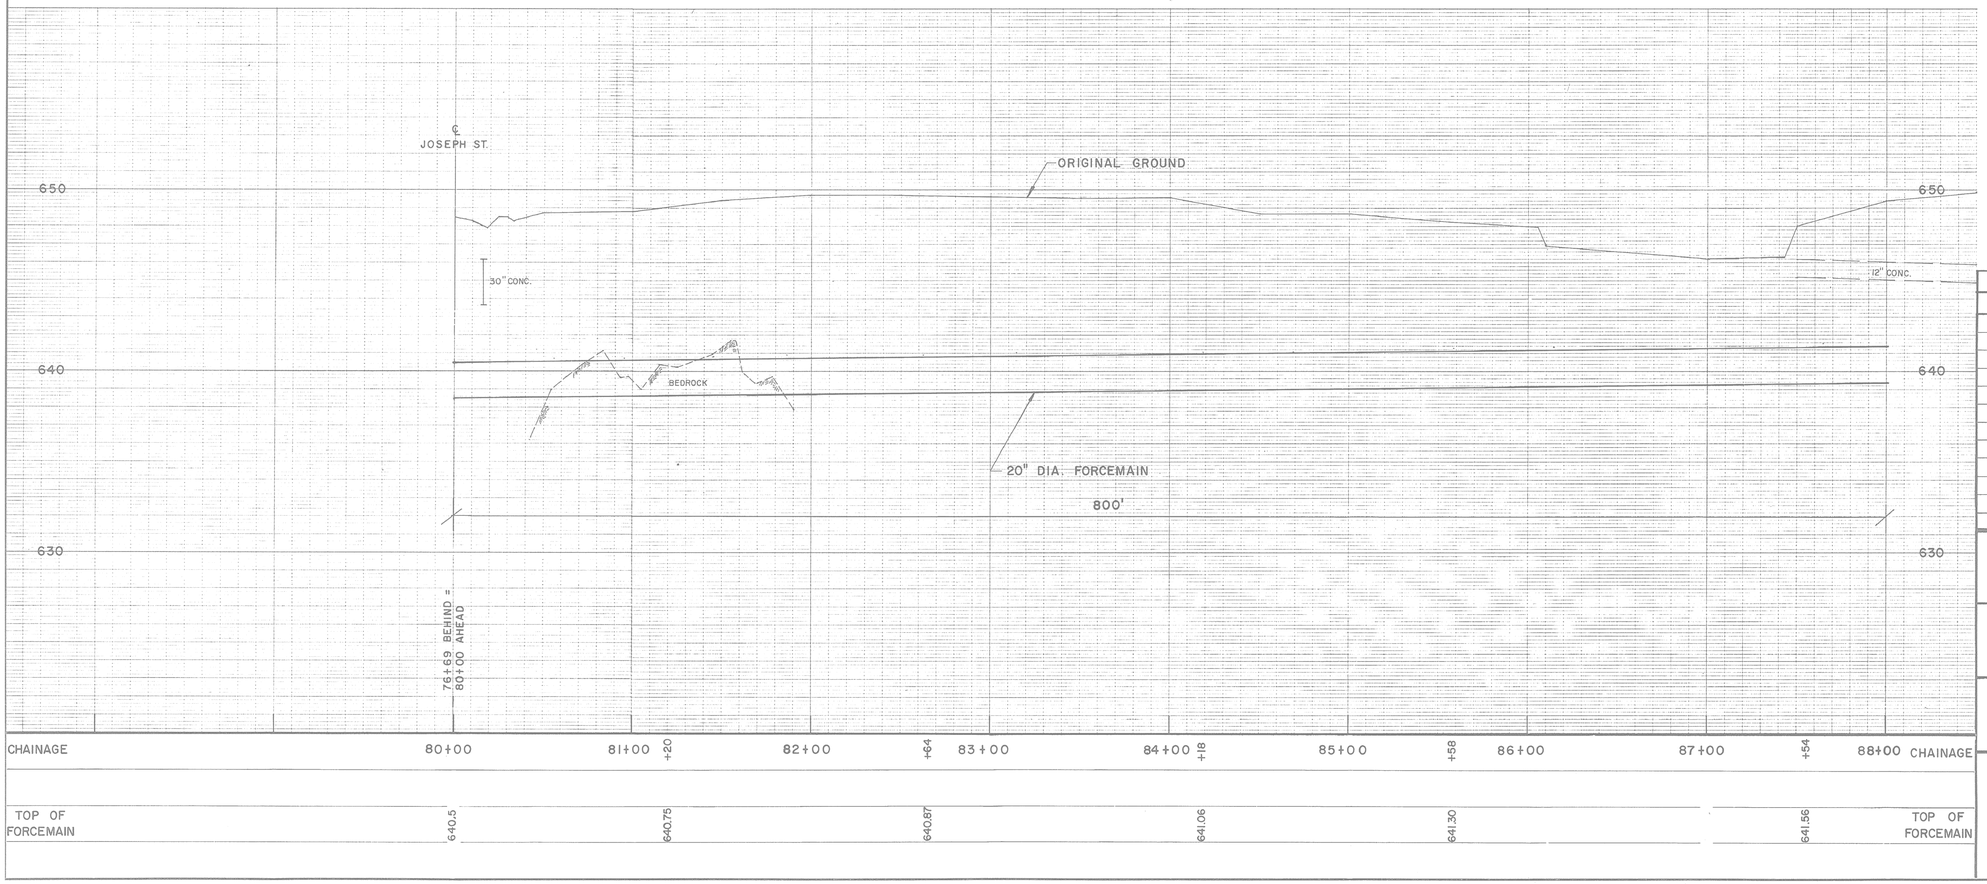

DISCLAIMER

The information contained on this drawing may be based upon data provided by others and may not have been verified by either as-constructed drawings or an Ontario Land Surveyor. The City of North Bay cannot accept responsibility for any errors or omissions on any information shown herein. Field verification, land surveys or excavation (with City approvals) may be required to determine actual location of any and all utilities or property lines.

GLADSTONE AVE.: COOMBES PARK

JOSEPH ST. TO MULLIGAN ST.

MK.	BY	REVISIONS	APP.	DATE
2.	R.E.A.	AS CONSTRUCTED.		MAR. '78
1	B.A.	FM GRADE CHANGE – ADDENDUM No.1	F.V.M.	21 OCT. '76

CITY OF NORTH BAY

MARSHALL AVE. PUMPING STATION & FORCEMAIN

20" DIA. FORCEMAIN
STA. 80+00 TO STA. 88+00

Northland Engineering Ltd.
CONSULTING ENGINEERS AND PLANNERS
NORTH BAY SUDBURY

DESIGN: F.V.M.	CHECKED: F.V.M.	DATE: OCT. 1976	
DRAWN: B.A. P.L.C.	APPROVED:	FIELD BOOK:	
SCALE: 1" = 40' HOR. 1" = 4' VERT.		CONTRACT No. 1	
PROJECT No. 1464-9		SHEET No. G-134	

TRANSLAR 250-1-75