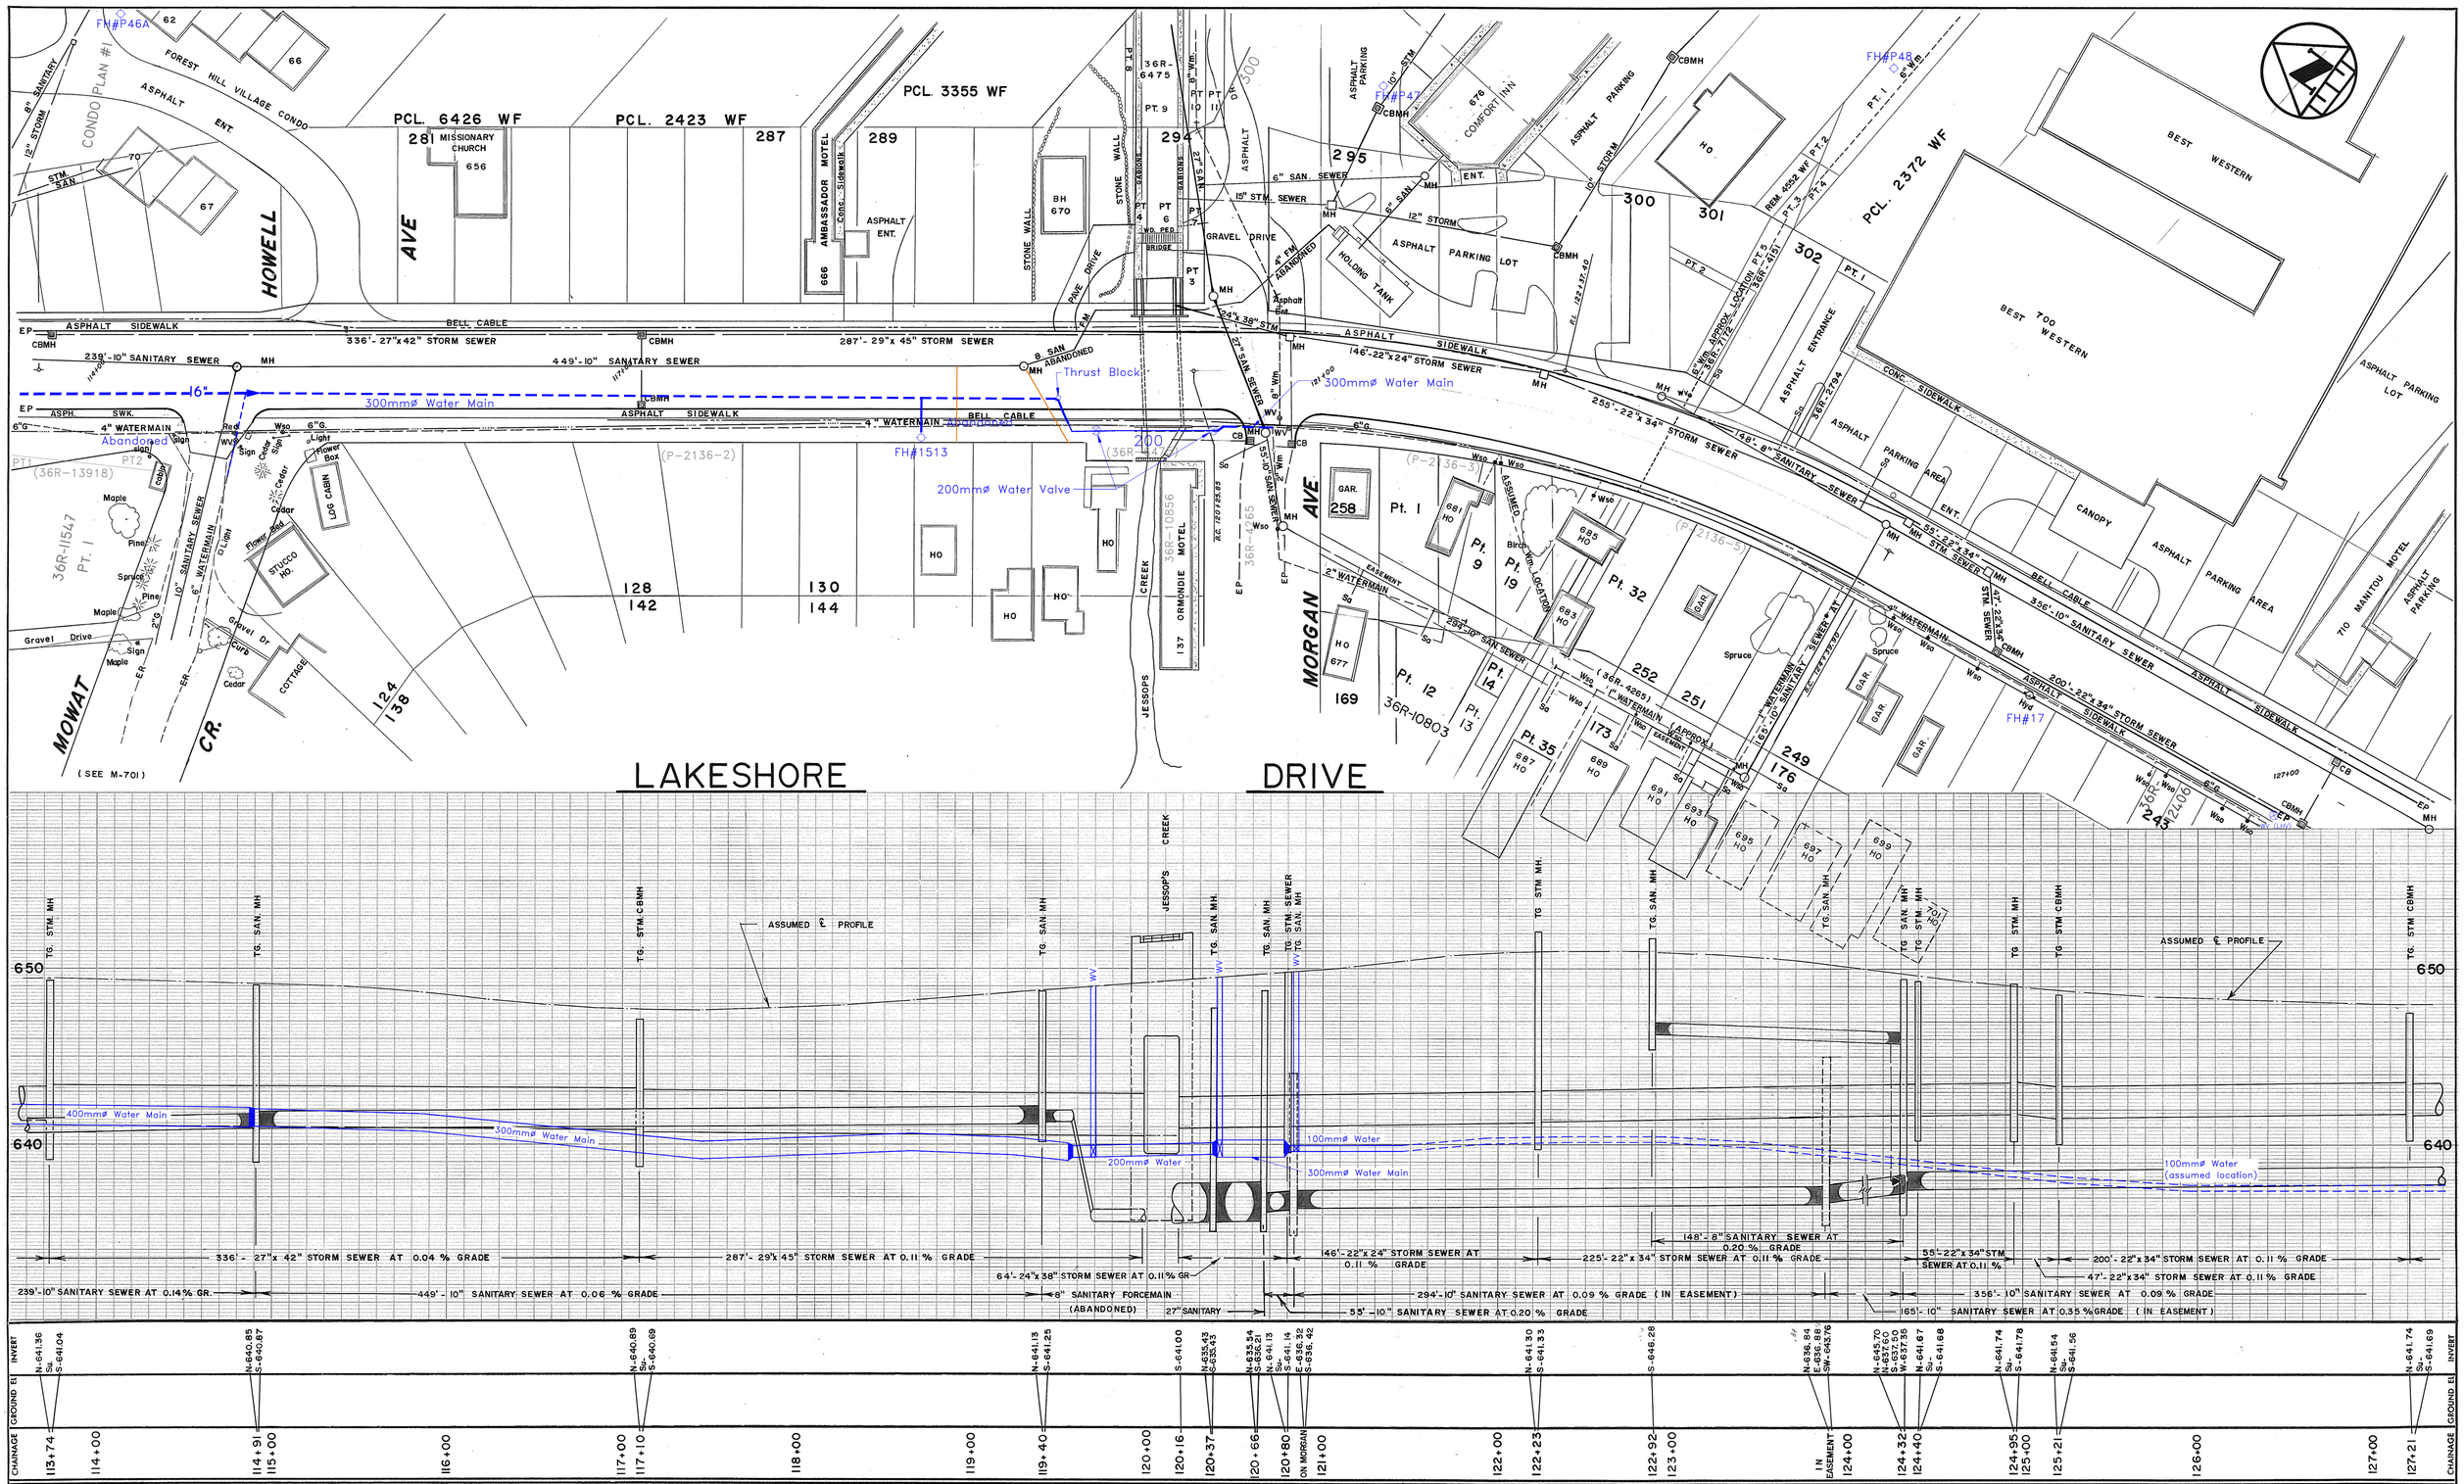

NOTES:

NORTH BAY

DISCLAIMER

The information contained on this drawing may be based upon data provided by others and may not have been verified by either as-constructed drawings or an Ontario Land Surveyor. The City of North Bay cannot accept responsibility for any errors or omissions on any information shown herein. Field verification, land surveys or excavation (with City approvals) may be required to determine actual location of any and all utilities or property lines.

No.	REVISION	DATE	INITIAL
1.	APPROX. SERV. LOCATION TO HO# 677 TO HO# 695	JAN/96	R.T.
2.	REGISTERED PLANS ADDED.	Nov 08	R.J.O.
3.	Updated Watermain	Oct'14	G.W.C.

APPROVED

LAKESHORE DRIVE

MOWAT CR TO BEST WESTERN

CITY OF NORTH BAY

ENGINEERING AND WORKS

SCALE: HOR - 1" = 40' VER - 1" = 4'

DATE: JAN/93

DRAWN BY: PLC

CK'D. BY:

FIELD BOOK No.

DRAWING No. L-460

REV.