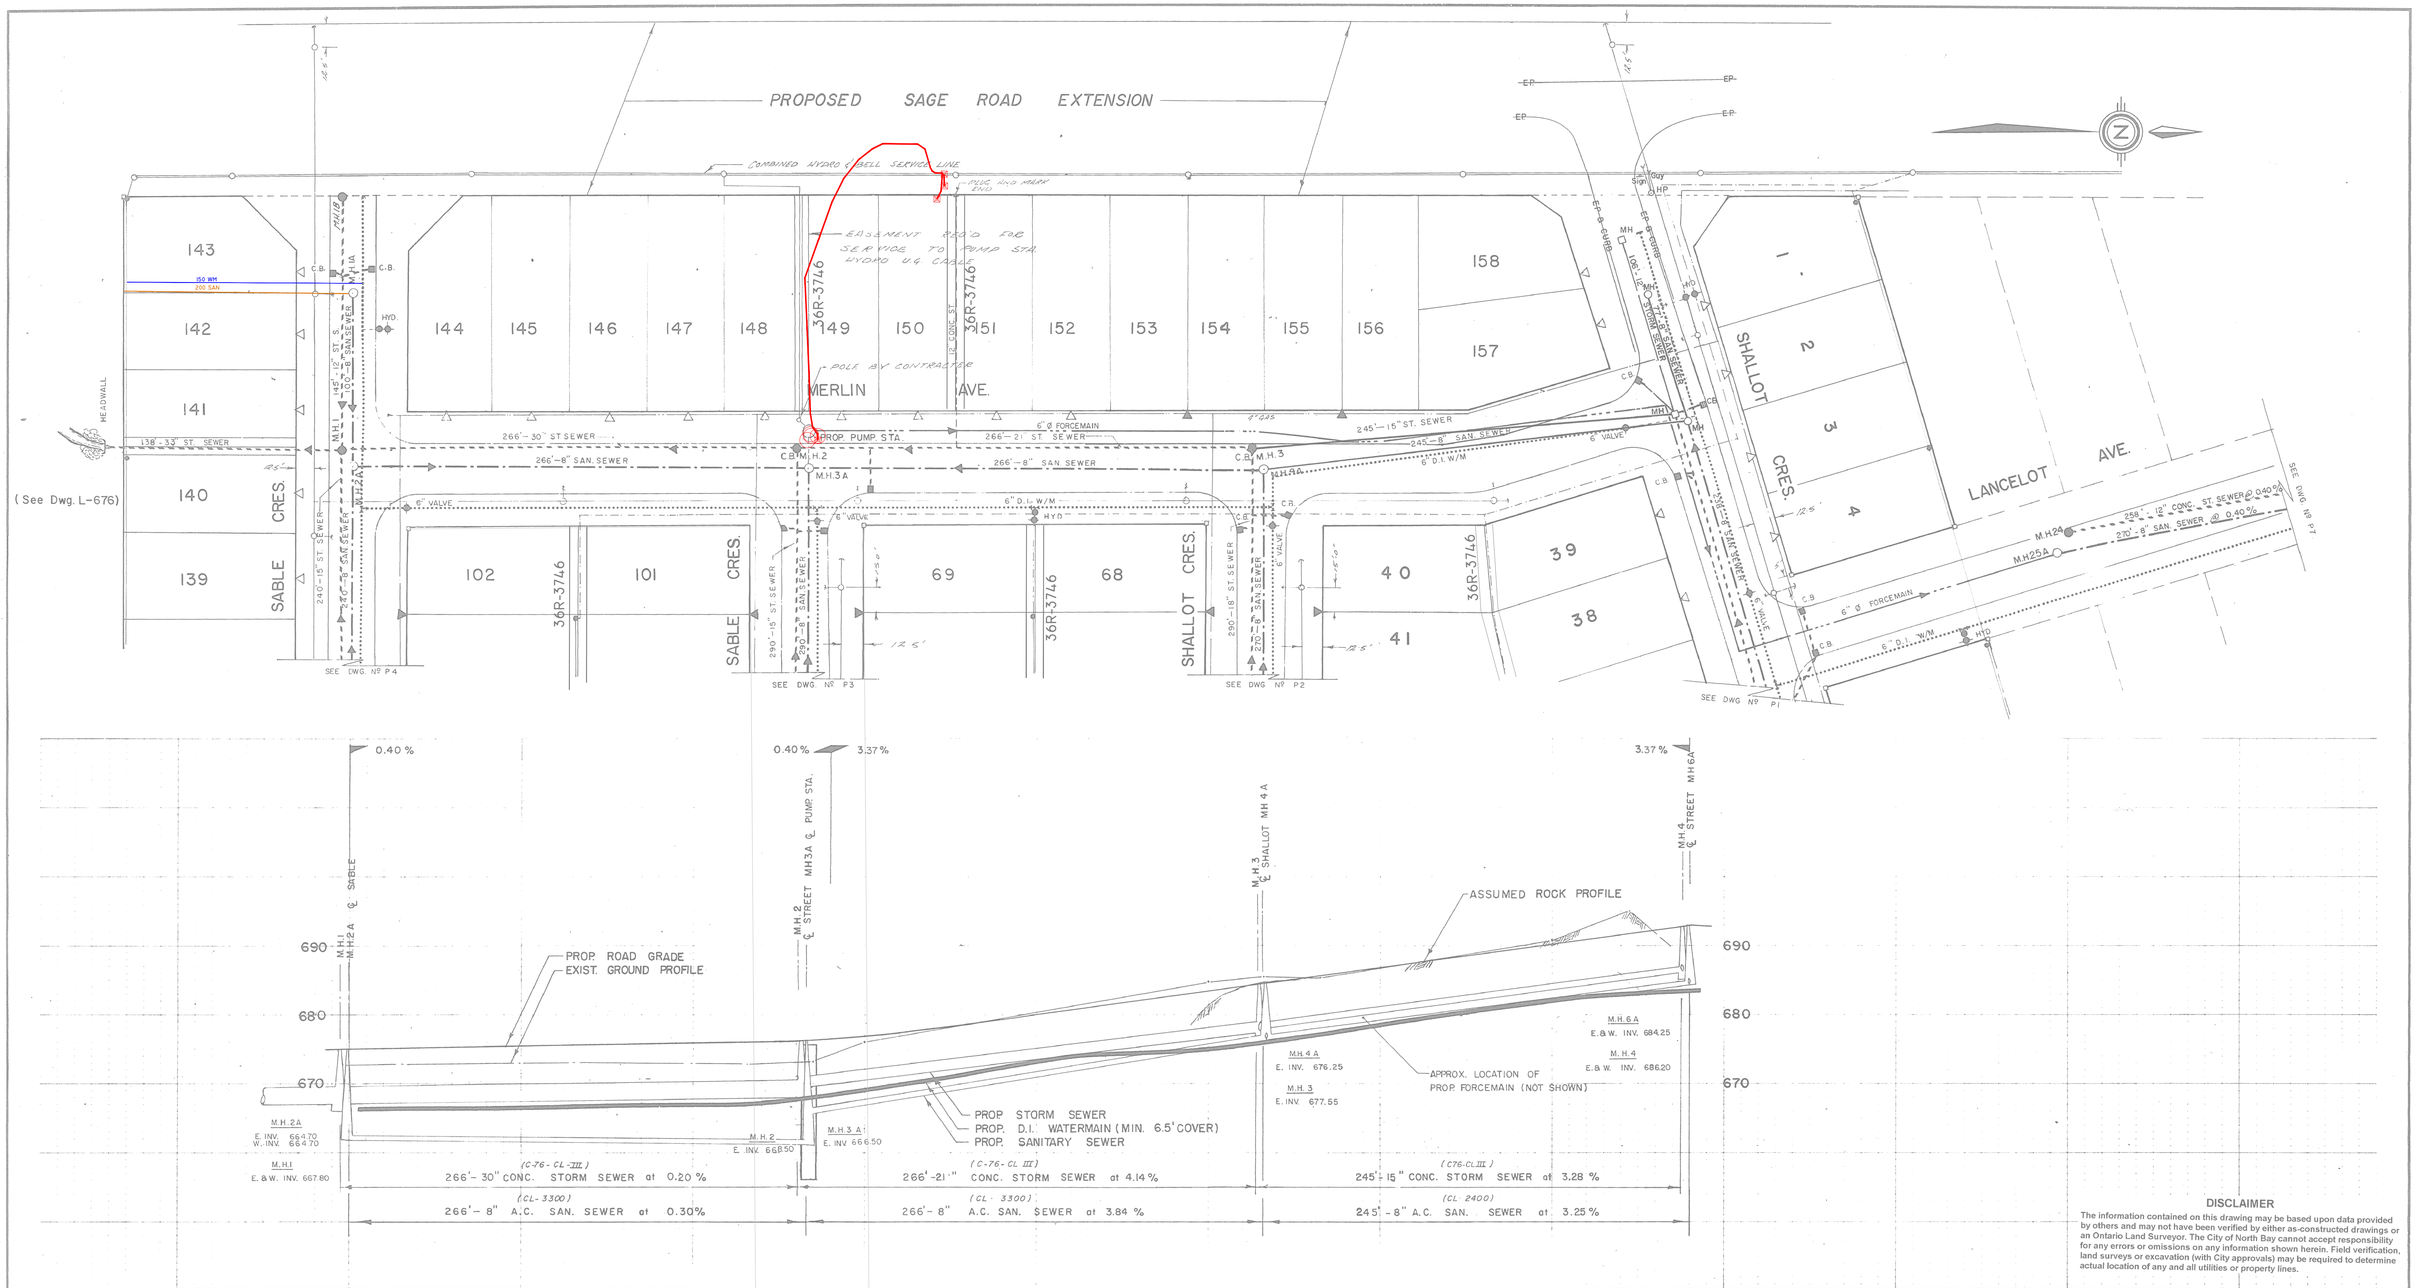

DISCLAIMER

The information contained on this drawing may be based upon data provided by others and may not have been verified by either as-constructed drawings or an Ontario Land Surveyor. The City of North Bay cannot accept responsibility for any errors or omissions on any information shown herein. Field verification, land surveys or excavation (with City approvals) may be required to determine actual location of any and all utilities or property lines.

Notes:

WATERMAIN TO BE DUCTILE IRON CLASS 2
FORCEMAIN TO BE SCHARPIPE SERIES 45 OR EQUAL

HYDRO PLANT APPROVED — DATE
NORTH BAY HYDRO
GAS PLANT APPROVED — DATE
NORTHERN & CENTRAL GAS CO.
BELL PLANT APPROVED — 18/9/74 DATE
BELL TELEPHONE CO.

THE POSITION OF POLE LINES, CONDUITS, WATERMAINS, SEWERS AND OTHER UNDERGROUND AND OVERGROUND UTILITIES AND STRUCTURES IS NOT NECESSARILY SHOWN ON THE CONTRACT DRAWINGS, AND, WHERE SHOWN, THE ACCURACY OF THE POSITION OF SUCH UTILITIES AND STRUCTURES IS NOT GUARANTEED. BEFORE STARTING WORK, THE CONTRACTOR SHALL INFORM HIMSELF OF THE EXACT LOCATION OF ALL SUCH UTILITIES AND STRUCTURES, AND SHALL ASSUME ALL LIABILITY FOR DAMAGE TO THEM.

No.	Revision	Date	Initial
5.	E-HYDRO TRAFFIC (APPROX)	APR 2021	RJO
4.	UPDATED MISSING WATER AND SAN	MAR 2012	G.W.C.
3.	REGISTERED PLAN ADDED.	DEC 2008	R.J.O.
2	CAD FILE: F:/CAD/ENG/SAGE PARK DETAIL REVISION INTERSECTION - MERLIN & SHALLOT	JULY 96	RT
1	ROAD GRADE REVISED ON MERLIN	NOV. 75	RAB

Approved

PRELIMINARY

CITY of NORTH BAY

PELLINORE PARK

MERLIN AVE.

STA. 0+00 to 7+80

Proctor & Redfern Limited
Consulting Engineers
Toronto North Bay

Scale Hor. 1" = 40' Vert 1" = 10'
Date: FEB/1974
Drawn By DON Ckd. By RUSS
Field Book
Drawing No. M-1101
Rev. 1