Scale 1" =

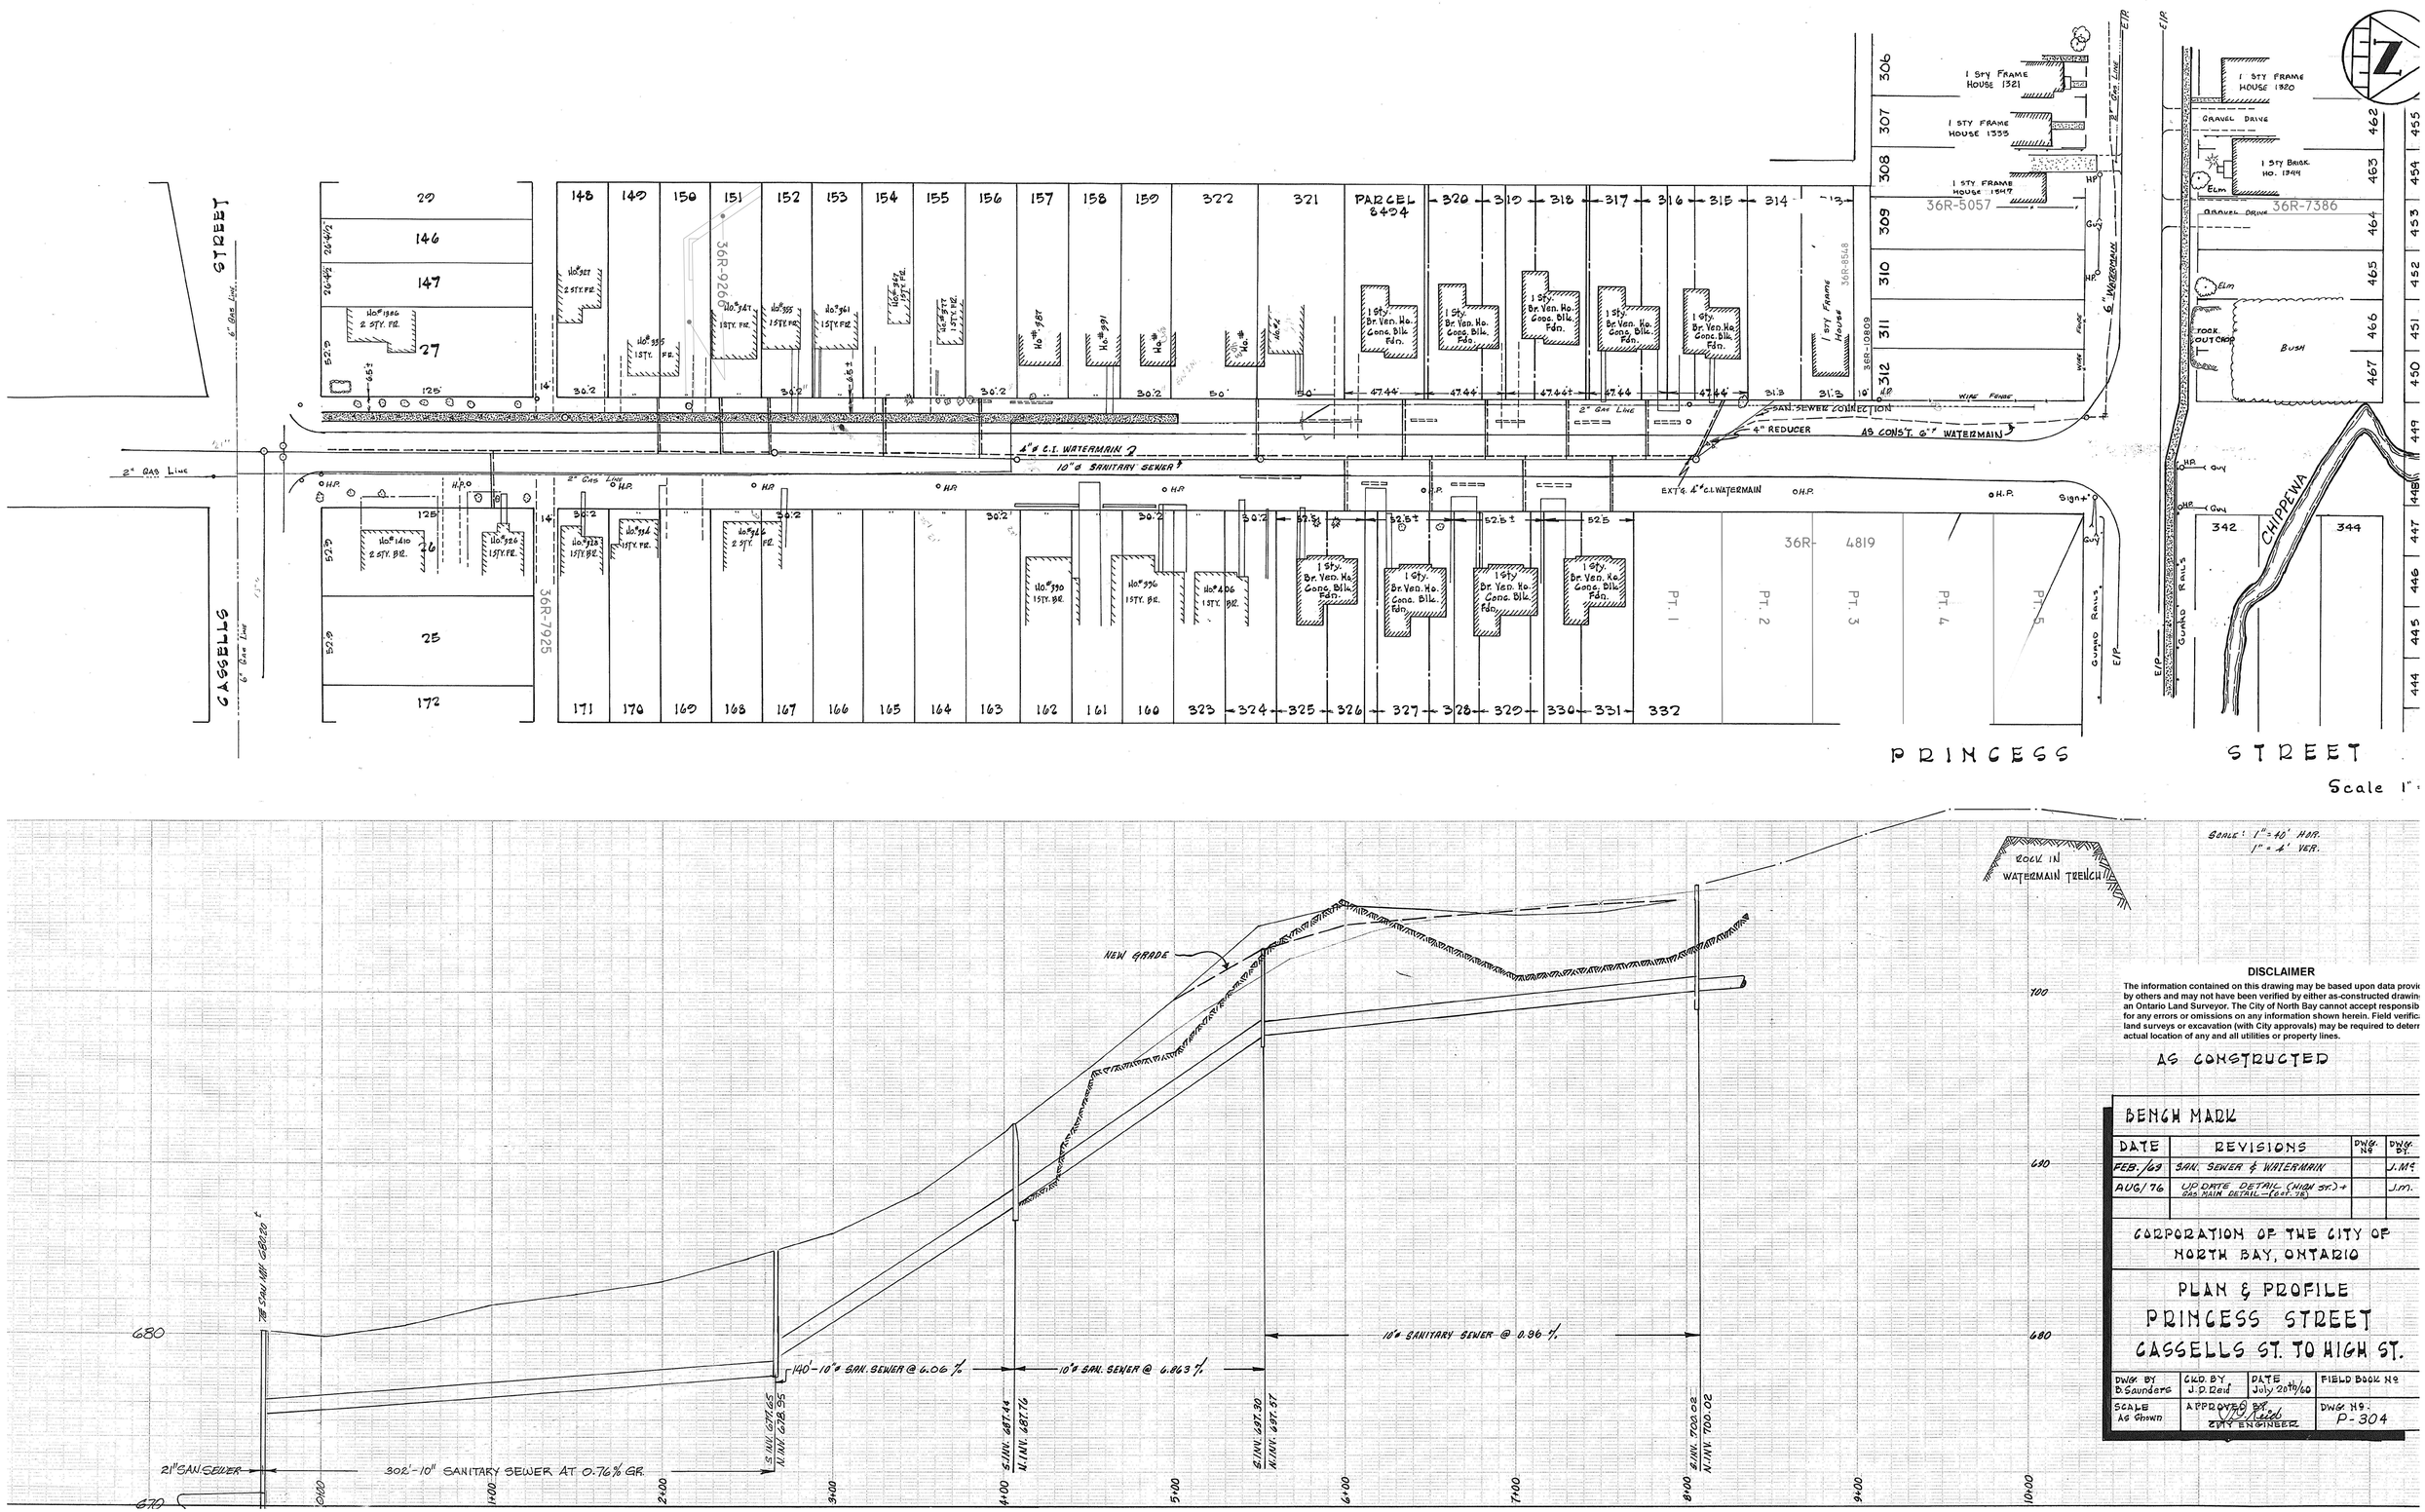

DISCLAIMER

The information contained on this drawing may be based upon data provi
by others and may not have been verified by either as-constructed drawin
an Ontario Land Surveyor. The City of North Bay cannot accept responsib
for any errors or omissions on any information shown herein. Field verific
land surveys or excavation (with City approvals) may be required to deter
actual location of any and all utilities or property lines.

AS CONSTRUCTED

BENCH MARK

DATE	REVISIONS	DWG. No	DWN BY
FEB./63	SAN. SEWER & WATERMAIN		J.M?
AUG/76	UPDATE DETAIL (HIGH ST.) + GAS MAIN DETAIL (EAST OF)		J.M.

CORPORATION OF THE CITY OF NORTH BAY, ONTARIO

PLAN & PROFILE

PRINCESS STREET

CASSELLS ST. TO HIGH ST.

DWG BY	CKD BY	DATE	FIELD BOOK No
D. Saunders	J.D. Reid	July 20th/60	
SCALE	APPROVED BY		DWG No:
As Shown	CITY ENGINEER		P-304