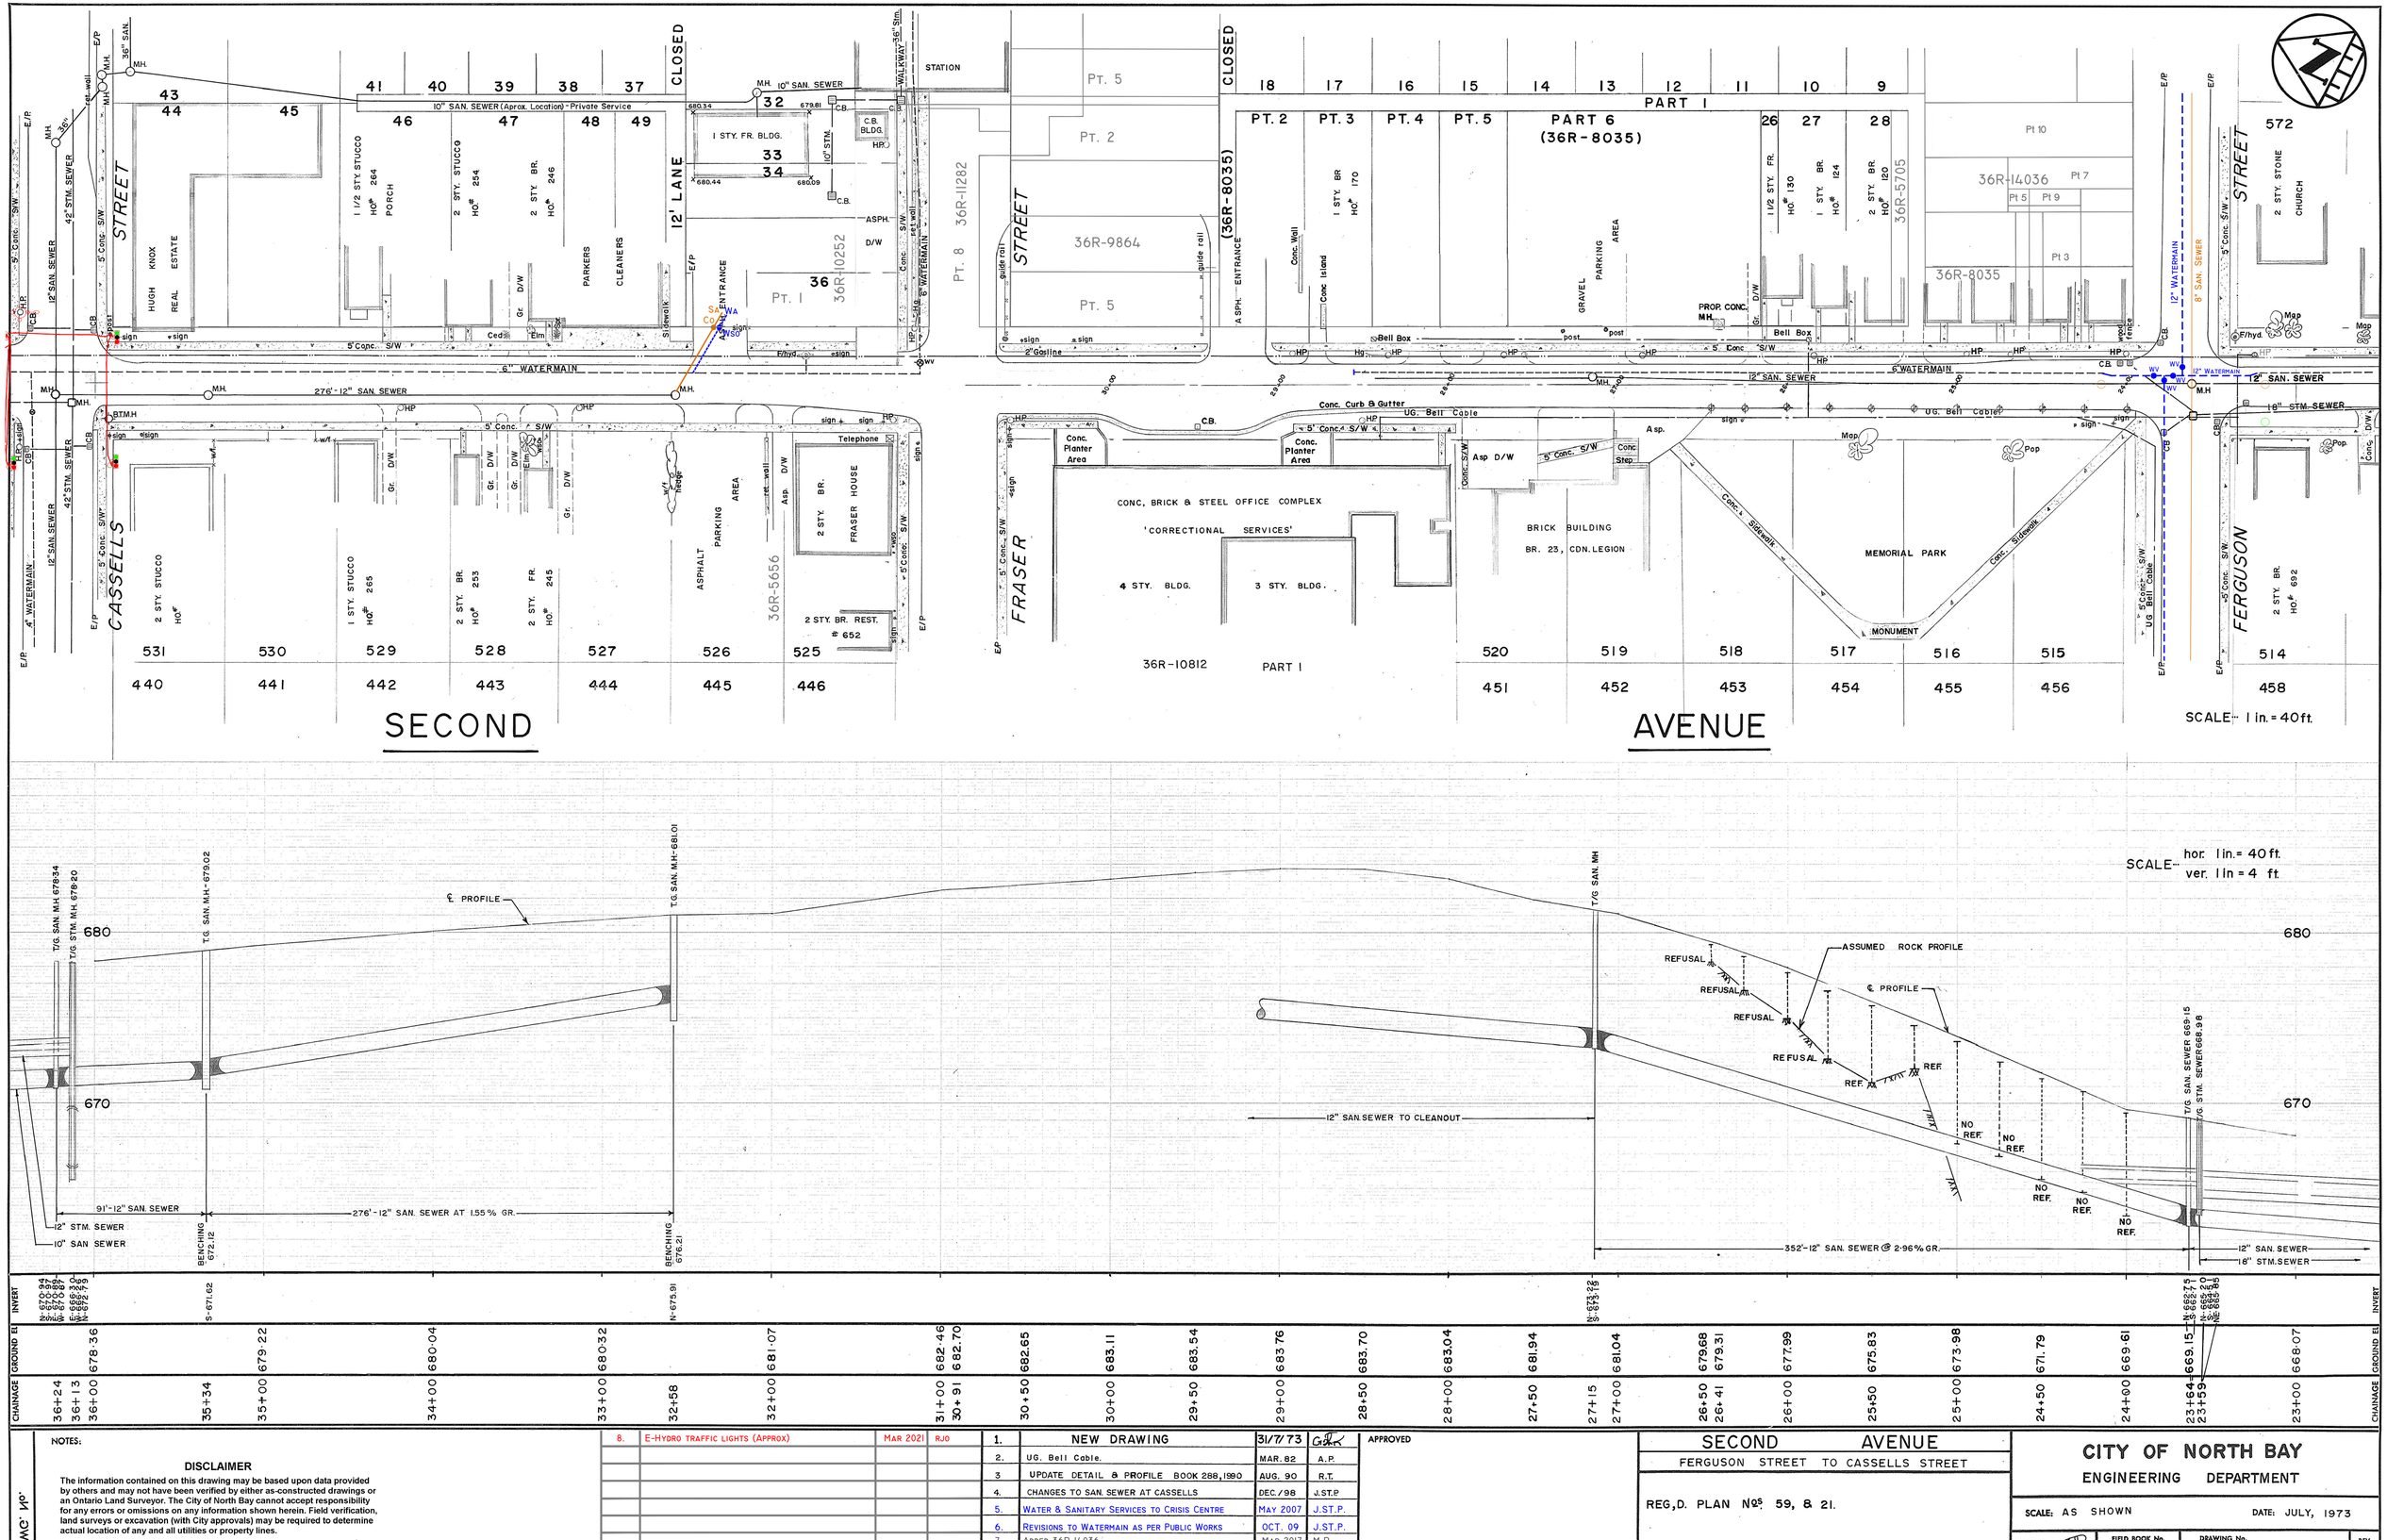

CHAINAGE	GROUND EL	INVERT
36+24	678.36	N- 670.94
36+13		S- 670.87
36+00		N- 672.79
35+34		S- 671.62
35+00	679.22	
34+00	680.04	
33+00	680.32	
32+58		N- 675.91
32+00	681.07	
31+00	682.46	
30+91	682.70	
30+50	682.65	
30+00	683.11	
29+50	683.54	
29+00	683.76	
28+50	683.70	
28+00	683.04	
27+50	681.94	
27+15		S- 673.25
27+00	681.04	
26+50	679.68	
26+41	679.31	
26+00	677.99	
25+50	675.83	
25+00	673.98	
24+50	671.79	
24+00	669.61	
23+64	669.15	S- 668.75
23+59		N- 669.20
23+00	668.07	

NOTES:

DISCLAIMER

The information contained on this drawing may be based upon data provided by others and may not have been verified by either as-constructed drawings or an Ontario Land Surveyor. The City of North Bay cannot accept responsibility for any errors or omissions on any information shown herein. Field verification, land surveys or excavation (with City approvals) may be required to determine actual location of any and all utilities or property lines.

No.	REVISION	DATE	INITIAL
8.	E-HYDRO TRAFFIC LIGHTS (APPROX)	MAR 2021	RJO
1.	NEW DRAWING	31/7/73	GAR
2.	UG. Bell Cable.	MAR. 82	A.P.
3	UPDATE DETAIL & PROFILE BOOK 288, 1990	AUG. 90	R.T.
4.	CHANGES TO SAN. SEWER AT CASSELLS	DEC./98	J.ST.P
5.	WATER & SANITARY SERVICES TO CRISIS CENTRE	MAY 2007	J.ST.P.
6.	REVISIONS TO WATERMAIN AS PER PUBLIC WORKS	OCT. 09	J.ST.P.
7.	ADDED 36R-14036	MAR 2017	M.R.

APPROVED

SECOND AVENUE
FERGUSON STREET TO CASSELLS STREET

REG,D. PLAN NOS. 59, & 21.

CITY OF NORTH BAY
ENGINEERING DEPARTMENT

SCALE: AS SHOWN
DATE: JULY, 1973

DRAWN BY: GAR
CK'D. BY:
FIELD BOOK No. 202
DRAWING No. S-154
REV.

DWG. No.