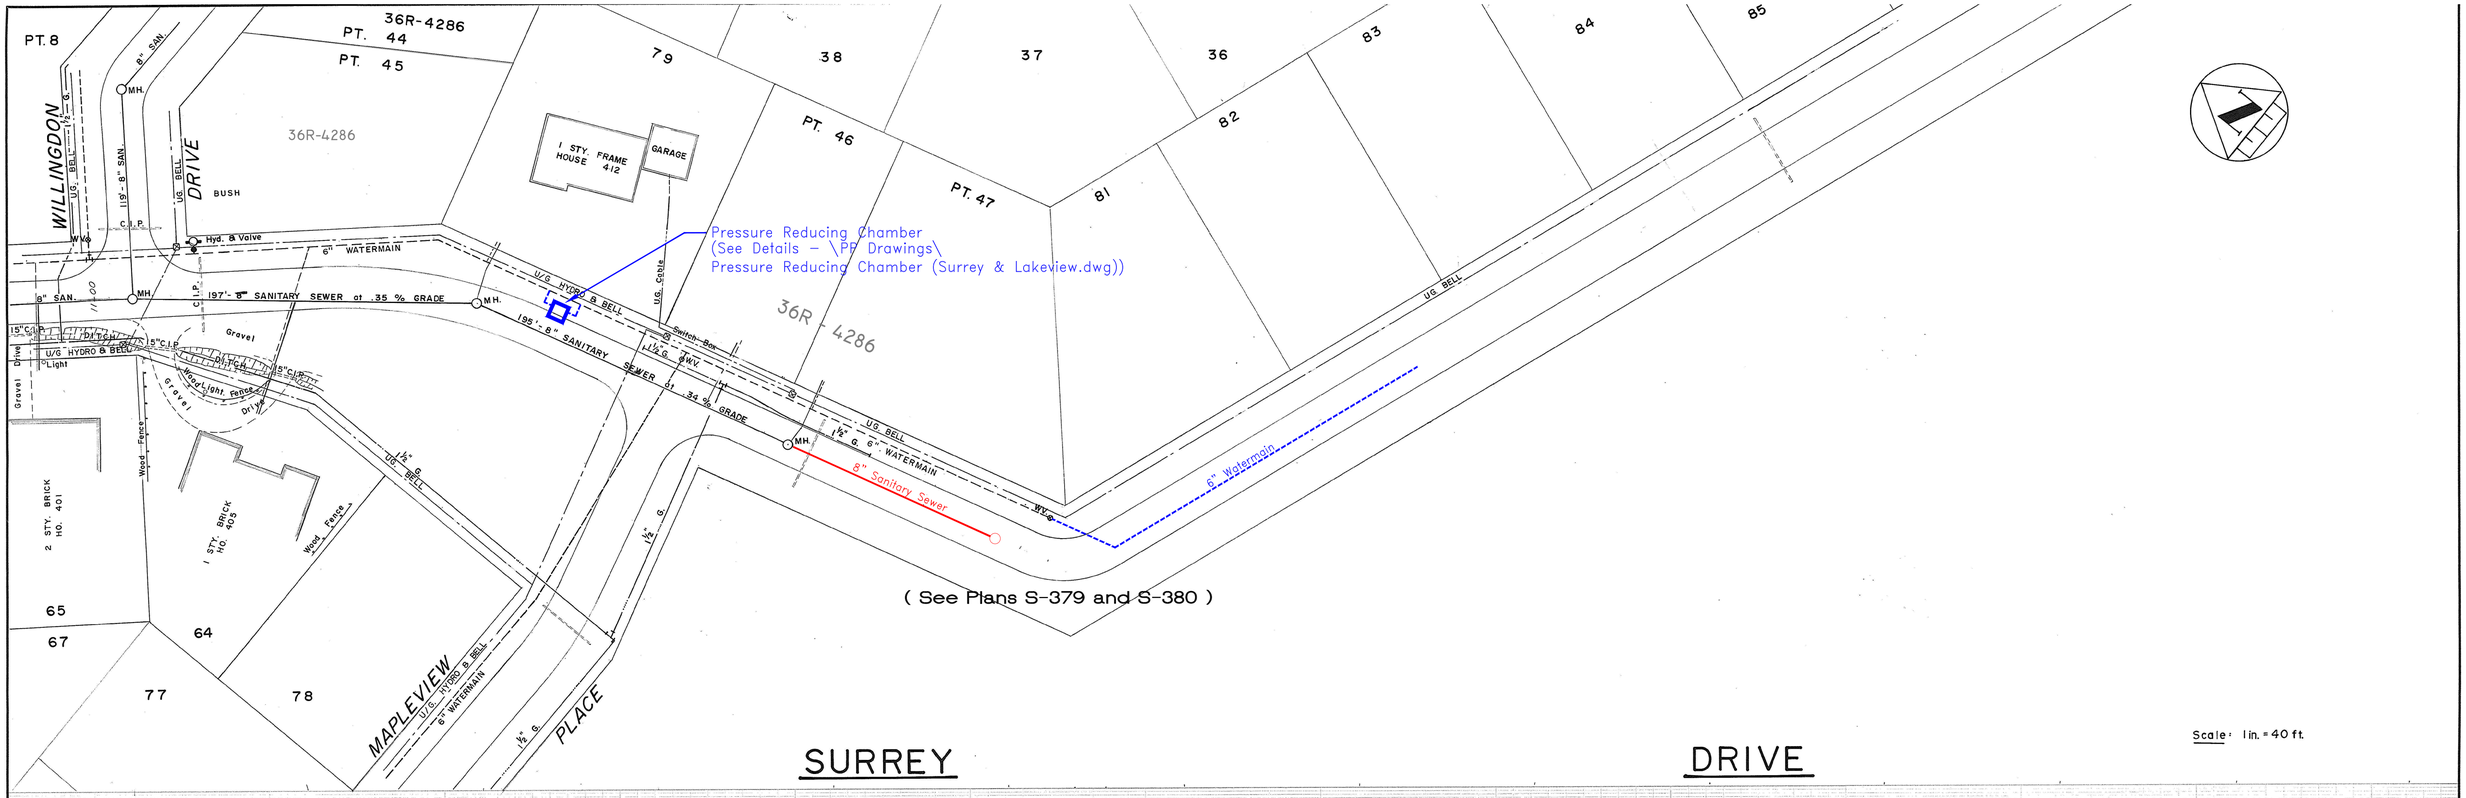

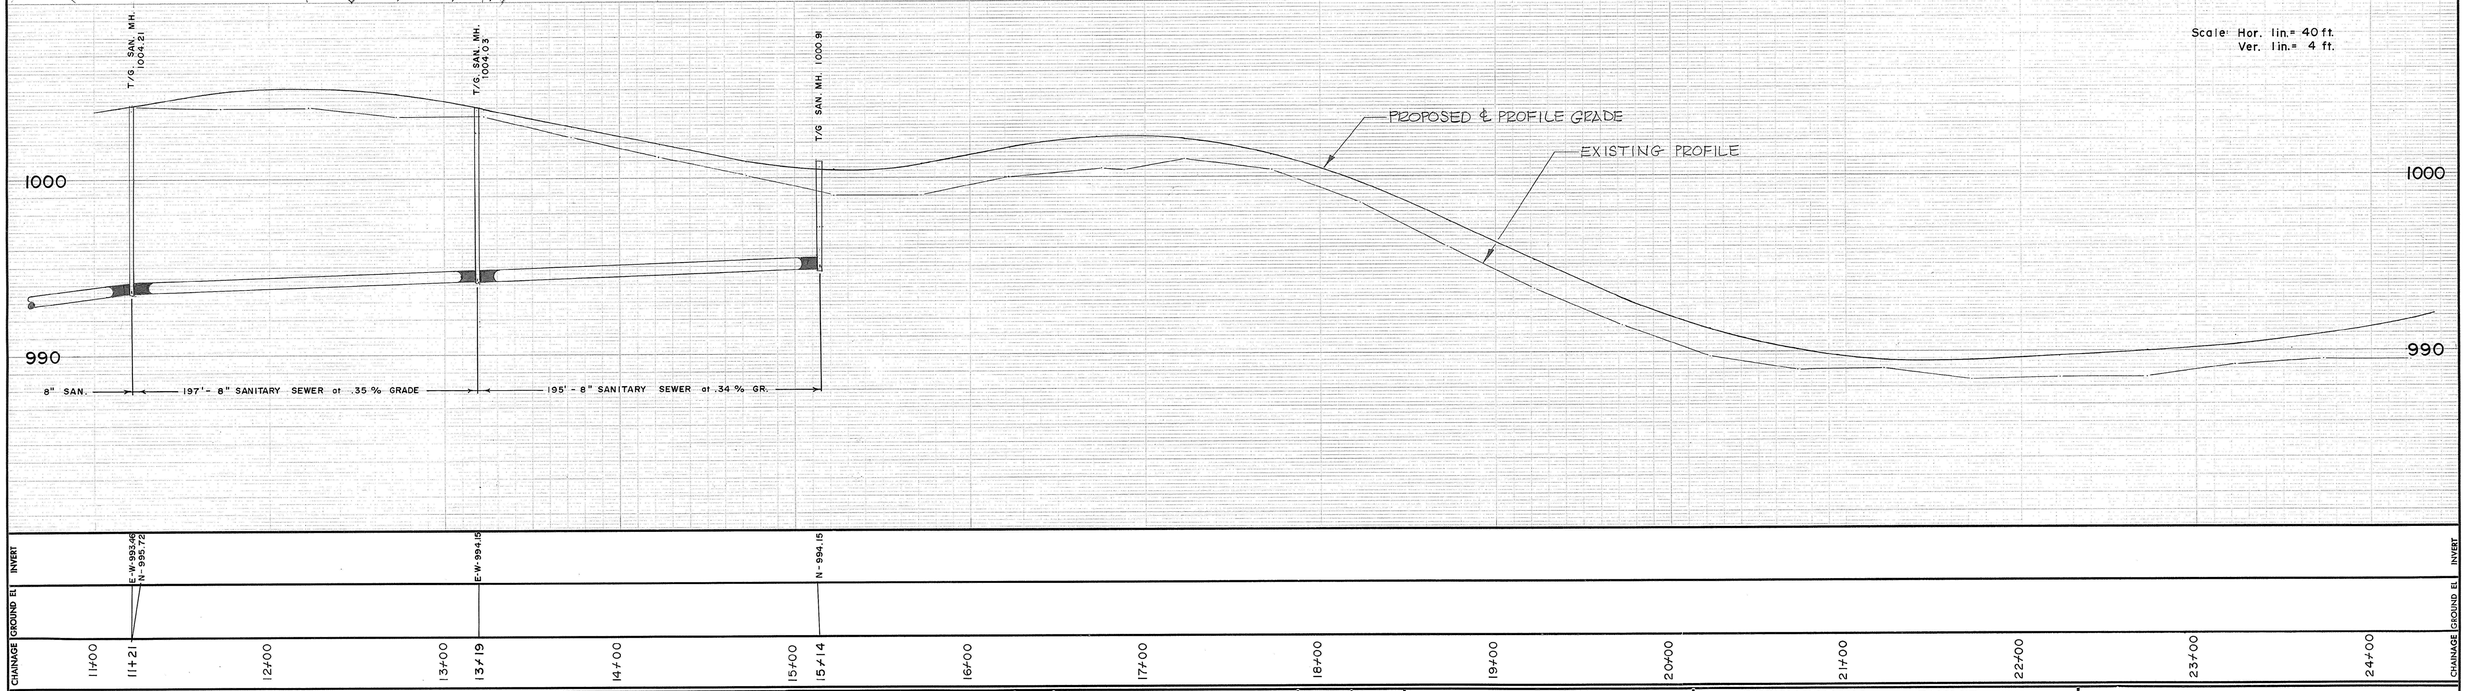

NOTES:

DISCLAIMER

The information contained on this drawing may be based upon data provided by others and may not have been verified by either as-constructed drawings or an Ontario Land Surveyor. The City of North Bay cannot accept responsibility for any errors or omissions on any information shown herein. Field verification, land surveys or excavation (with City approvals) may be required to determine actual location of any and all utilities or property lines.

DWG No.

No.	REVISION	DATE	INITIAL
1.	NEW DRAWING	JAN./75	BD
2.	AS CONS'T SAN. & WM.	FEB. 77	j.d.m.
3	Spelling Correction.	Aug/ 77	j.d.m.
4.	UNDER GROUND HYDRO & BELL	June / 78	j.d.m.
5.	6" WATERMAIN ON MAPLEVIEW PL.	OCT. '01	J.ST.P.
6.	Add Pressure Reducing Chamber	OCT. '08	J.ST.P.

APPROVED

SURREY DRIVE

LAURENTIAN DRIVE TO STA. 24+00

REG'D PLAN M-312, 36R-4286

CITY OF NORTH BAY

ENGINEERING DEPARTMENT

SCALE: AS SHOWN

DATE: JAN. 1975

DRAWN BY: B.D. CK'D. BY:	FIELD BOOK No. 191, 246	DRAWING No. S-377	REV.