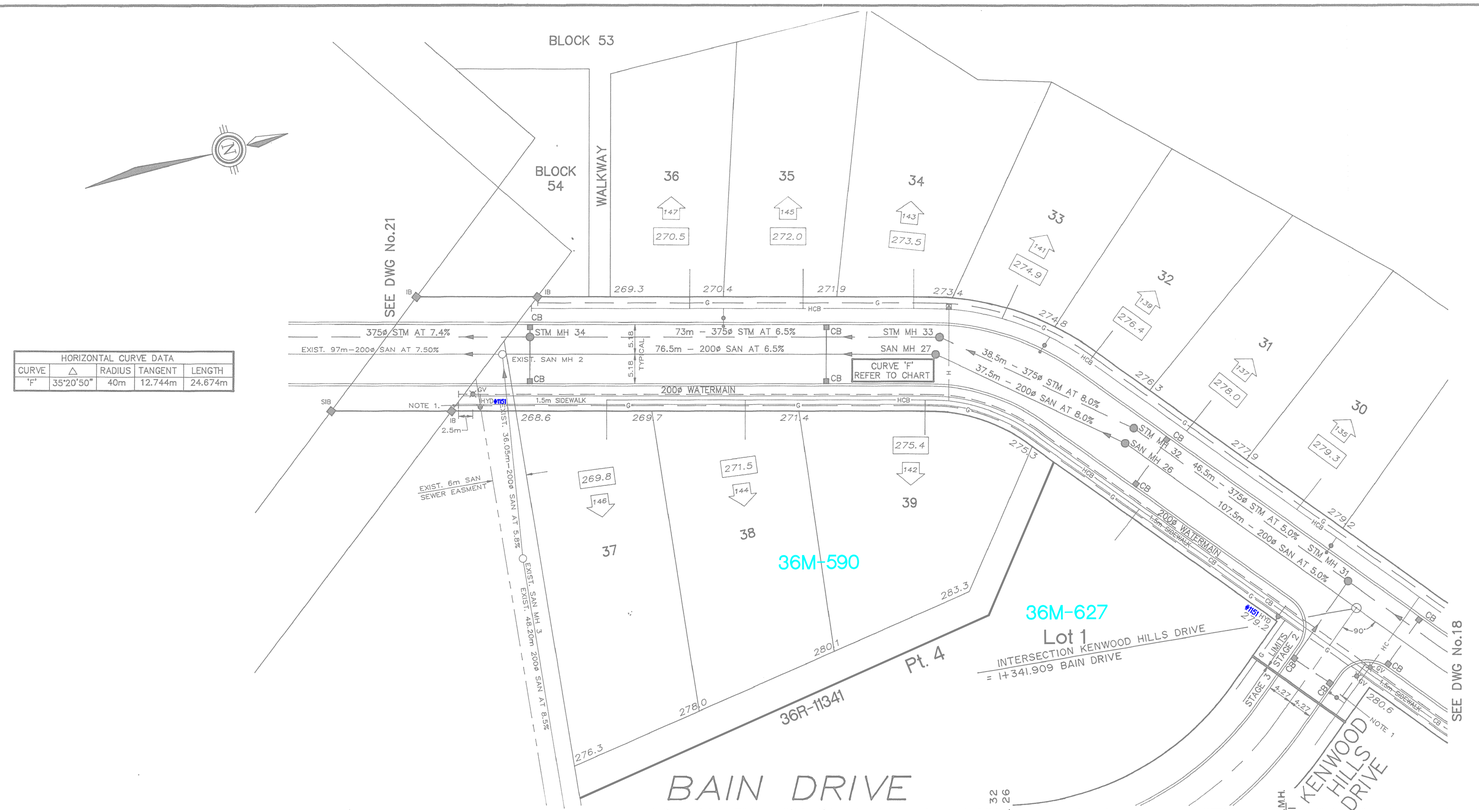

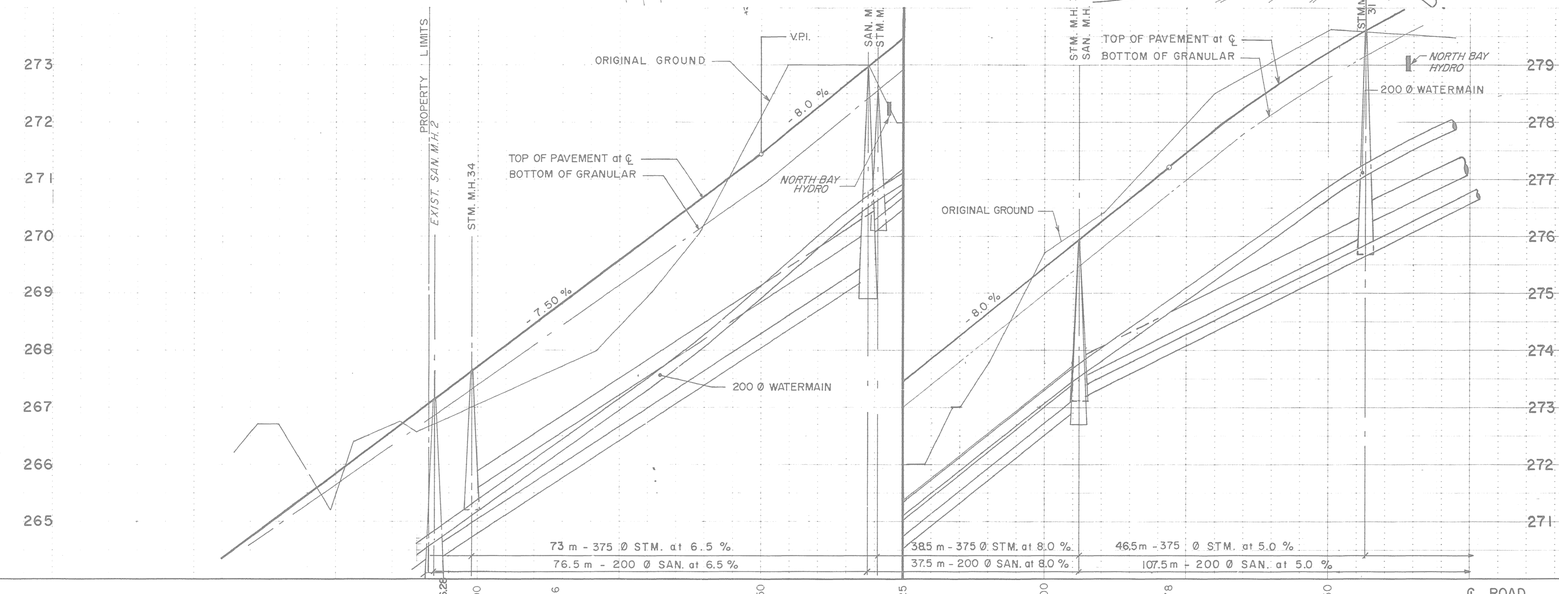

℄ ROAD CHAINAGE			0+506.28	1+500	1+466	1+450	1+425	1+400	1+378	1+350	℄ ROAD CHAINAGE
TOP OF PAVEMENT ELEVATION			267.229	267.675	268.750	271.450	273.450	275.450	277.210	279.189	TOP OF PAVEMENT ELEVATION
STORM SEWER INVERTS				N265.45			S270.20 N270.47			S276.00 N276.20	STORM SEWER INVERTS
SANITARY SEWER INVERTS	S264.25 E264.91 N264.33						S269.30 N270.00	S273.55 N273.67	S273.00 N273.10		SANITARY SEWER INVERTS
TOP OF WATERMAIN ELEVATION				265.40		269.15		273.30		276.85	TOP OF WATERMAIN ELEVATION

B-1279

TRANSLAR

REFERENCE

DWG Nº	DESCRIPTION

NOTES:

1. CAP ENDS OF 200 Ø WATERMAIN

DISCLAIMER

The information contained on this drawing may be based upon data provided by others and may not have been verified by either as-constructed drawings or an Ontario Land Surveyor. The City of North Bay cannot accept responsibility for any errors or omissions on any information shown herein. Field verification, land surveys or excavation (with City approvals) may be required to determine actual location of any and all utilities or property lines.

LEGEND

× 286.72	TOP OF PAVEMENT ELEVATION AT CURB
287.6	FINAL ELEVATION AT LOT CORNER
290.3	MINIMUM LOT ELEVATION AT BUILDING
289.4	SWALE ELEVATION
126	HOUSE NUMBERS
	PROPOSED HYDRO TRANS.
	PROPOSED STREET LIGHT
	NORTH BAY HYDRO PROFILE ROAD CROSSING

GAS PLANT APPROVED	CATV PLANT APPROVED
Sept 24/90	July 11/91
CENTRA GAS (ONTARIO) LTD. DATE	MACLEAN HUNTER CABLE TV DATE
HYDRO PLANT APPROVED	**BELL PLANT APPROVED**
July 11/91	[illegible]
NORTH BAY HYDRO DATE	BELL CANADA LTD. DATE

APP'D BY	DETAILS	DATE	Nº
	REVISIONS		
r.i.o.	Registered Plans Added.	May'07	B
M.B.B.	SAN. & STM. SEWER LENGTHS	JULY/91	A
M.B.B.	END W.M. at SOUTHERN LIMITS & CAP	FEB.27/91	1

RECOMMENDED BY

APPROVED BY

KENWOOD HILLS DEVELOPMENT

KENWOOD HILLS SUBDIVISION

BAIN DRIVE

northland engineering limited
Consulting Engineers and Planners
NORTH BAY SUDBURY TIMMINS

DRAWN BY: M.K.F.	DATE: JUNE, 1990		
CHECKED BY: M.B.B. / B.D.	SCALE: HORIZ. 1:500 VERT. 1:50		
FIELD BOOK:			
OFFICE North Bay	PROJECT Nº 1234	DRAWING Nº B-1279	REV.