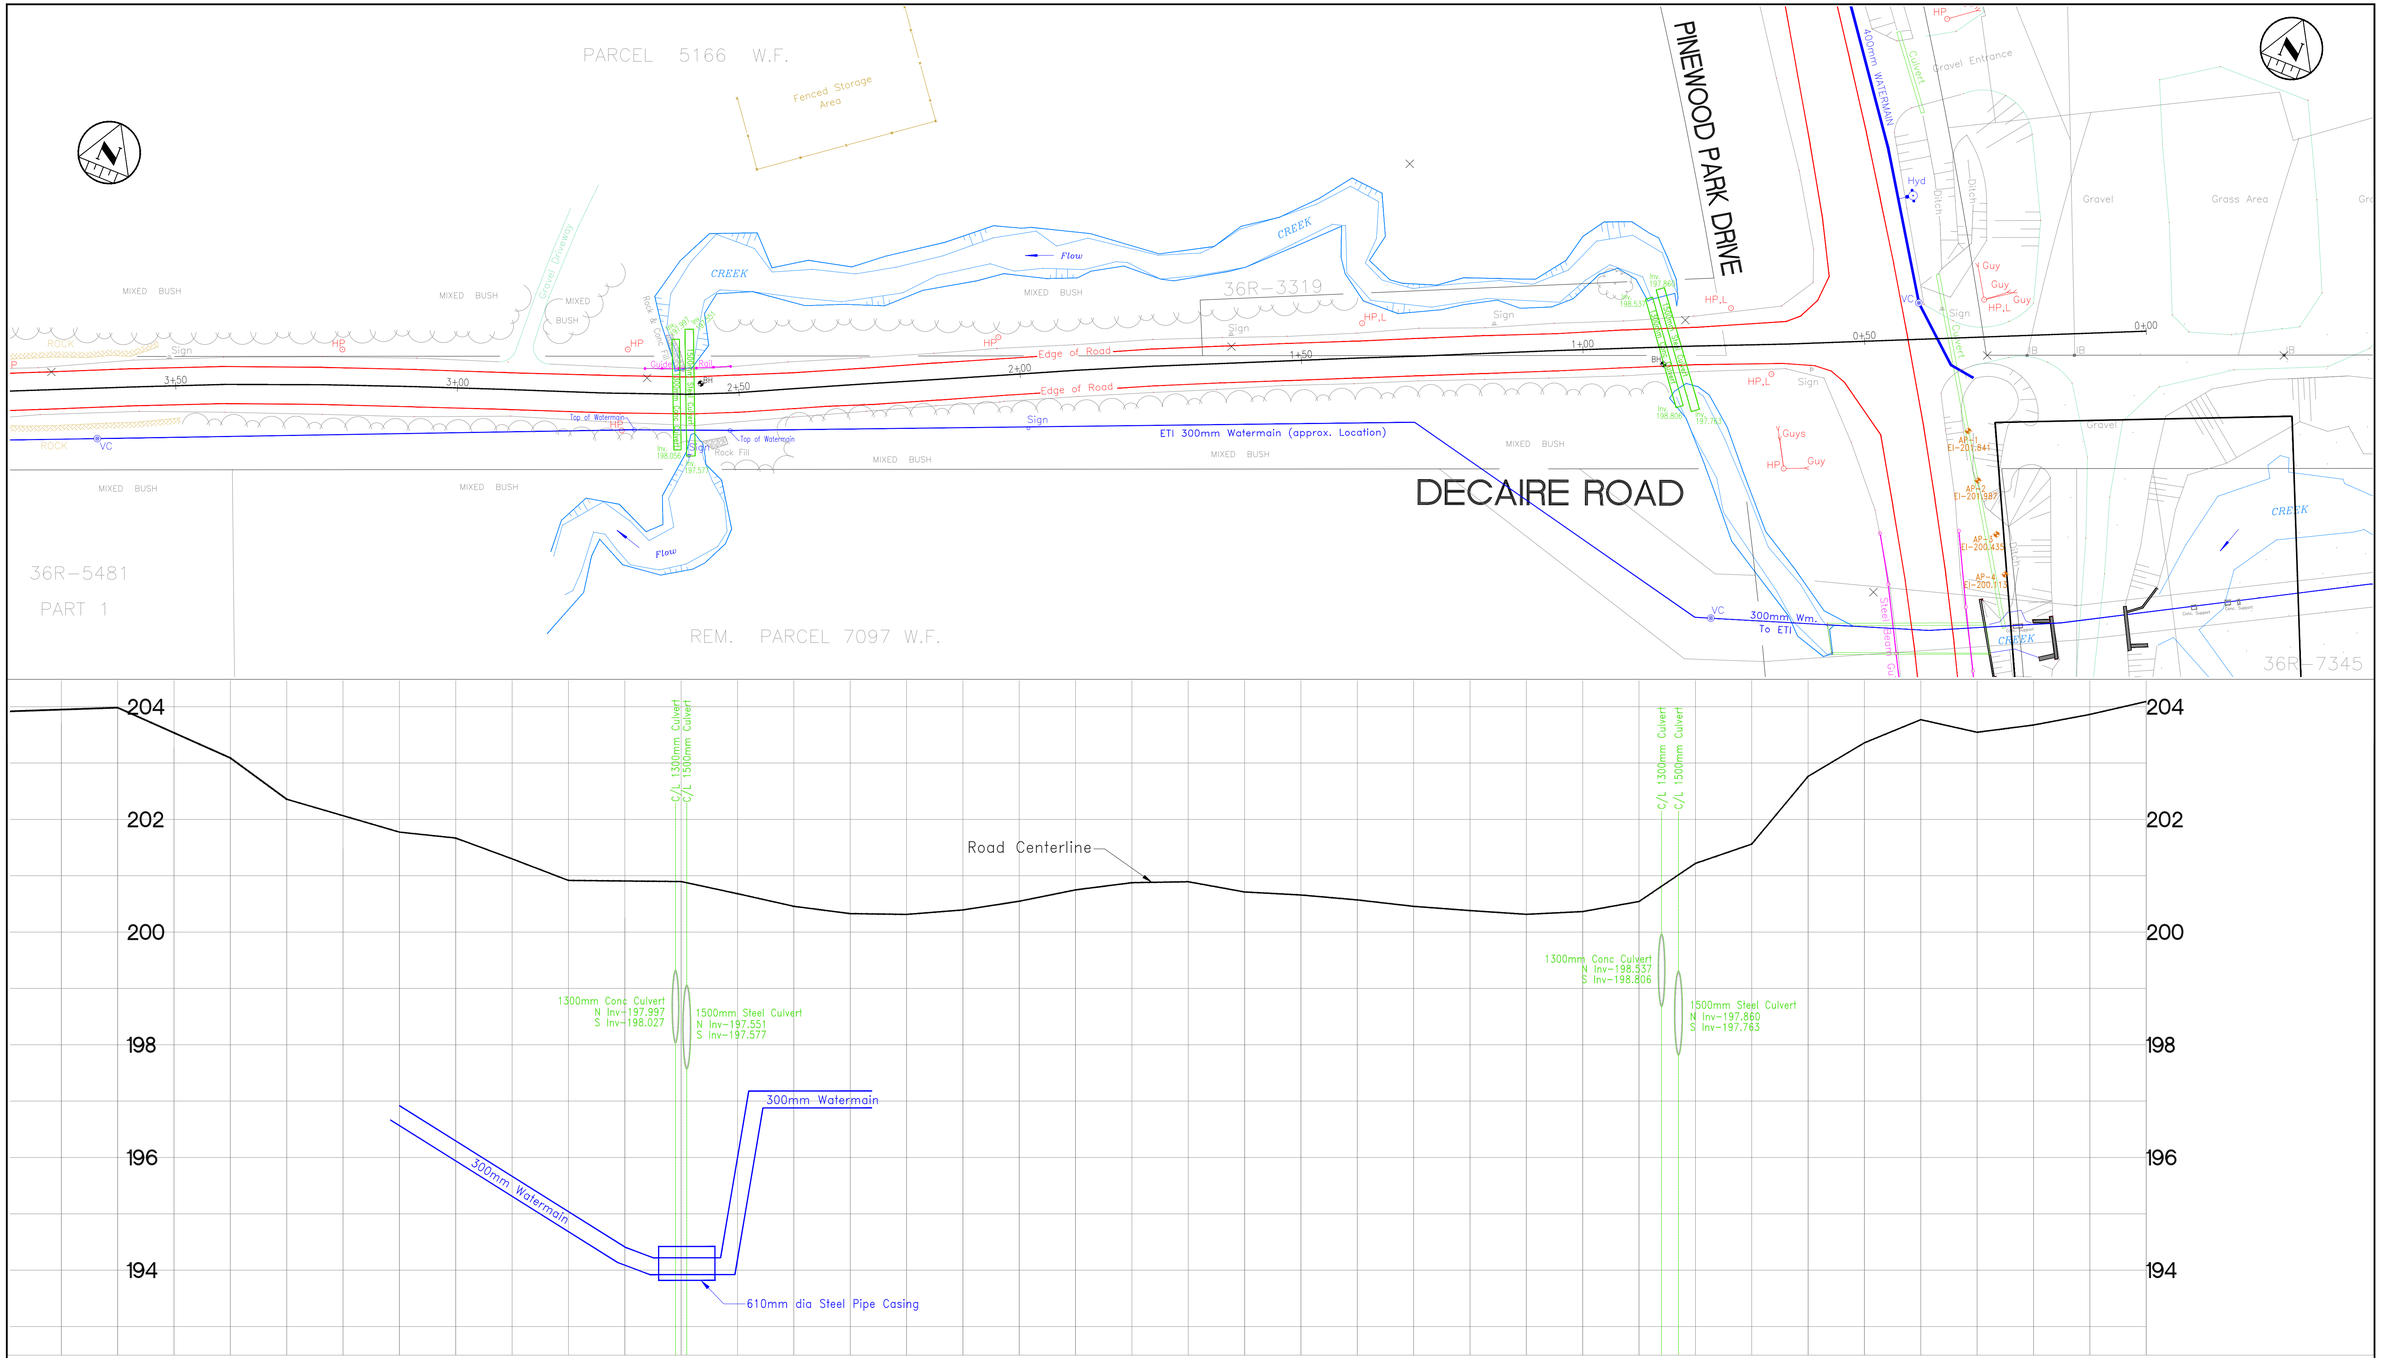

CHAINAGE	3+60	3+40	3+20	3+00	2+80	2+60	2+40	2+20	2+00	1+80	1+60	1+40	1+20	1+00	0+80	0+60	0+40	0+20	0+00
GROUND EL.	203.983	203.267	203.090	202.358	201.475	201.774	201.669	201.300	200.917	200.244	200.897	200.682	200.458	200.327	200.314	200.393	200.547	200.749	200.877	200.893	200.712	200.658	200.571	200.457	200.382	200.315	200.364	200.543	201.219	201.562	202.763	203.359	203.770	203.546	203.675	203.862	204.092
INVERT																																					

NOTES:
1- As Constructed Culvert Locations & Inverts – Dec. 2002

No.	REVISION	DATE	INITIAL

I:\CAD\ENG\Decaire Rd\DECAIRE.dwg
Plan – 841mm x 594mm

Prepared By : CITY OF NORTH BAY
ENGINEERING DEPARTMENT
200 McINTYRE ST. E.
NORTH BAY, ONTARIO
474-0400 FAX 495-0936

NORTH BAY ONTARIO · CANADA
Just North Enough to be PERFECT

City of North Bay
Engineering and Environmental Services

DECAIRE ROAD
PINEWOOD PARK DR to CHAINAGE 3+50

Drawn By: J.ST.P.
Ck'd. By:
SCALE : METRIC Hor.– 1:500 Vert.– 1:50
DATE : FEB. 2008
DRAWING No. D-451