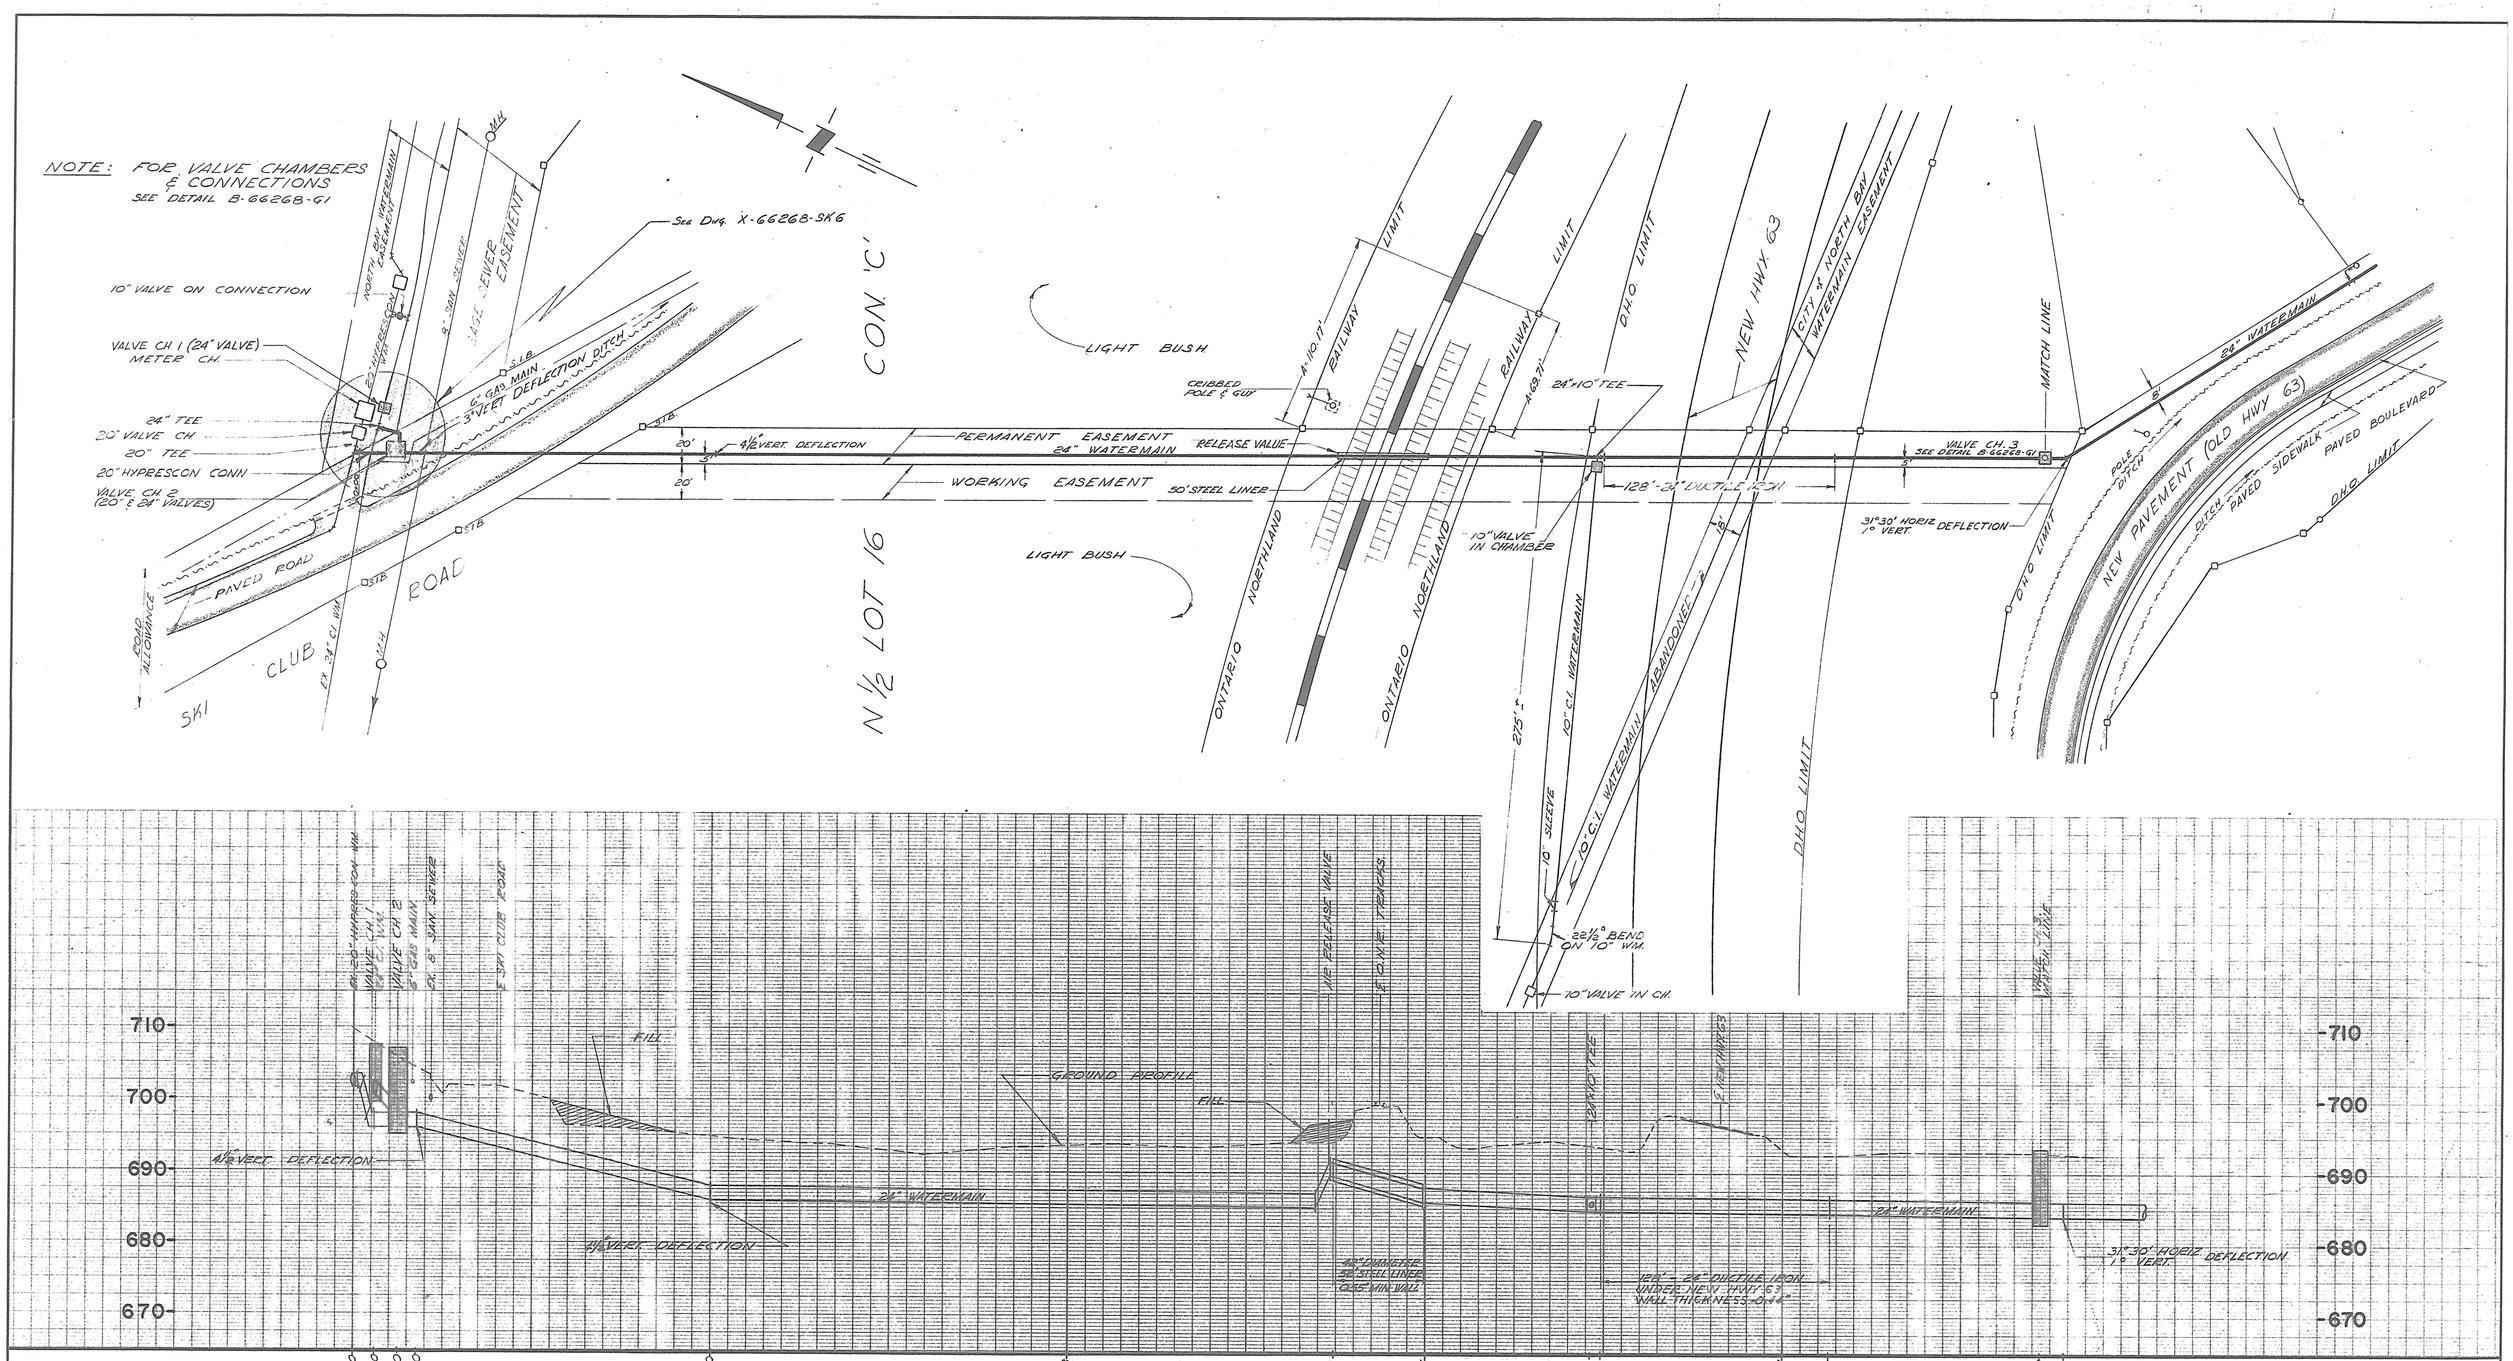

L-407

NOTES: (1) ALL PIPE & SPECIALS 24" REINFORCED CONCRETE AWWA CLASS C 301 UNLESS OTHERWISE NOTED.

NORTH BAY

DISCLAIMER

The information contained on this drawing may be based upon data provided by others and may not have been verified by either as-constructed drawings or an Ontario Land Surveyor. The City of North Bay cannot accept responsibility for any errors or omissions on any information shown herein. Field verification, land surveys or excavation (with City approvals) may be required to determine actual location of any and all utilities or property lines.

No.	REVISION	DATE	INITIAL
1	AS CONSTRUCTED	9/68	R.A.

APPROVED

CITY of NORTH BAY

24" TRUNK WATERMAIN PUMPHOUSE TO SKI CLUB ROAD

PROCTOR & REDFERN
CONSULTING ENGINEERS TORONTO

SCALE: HORIZ. 1" = 40' VERT. 1" = 10'

DATE: MARCH, 1967

DRAWN BY: M.T.
CK'D. BY:

FIELD BOOK No.

DRAWING No. L-407

REV. 1