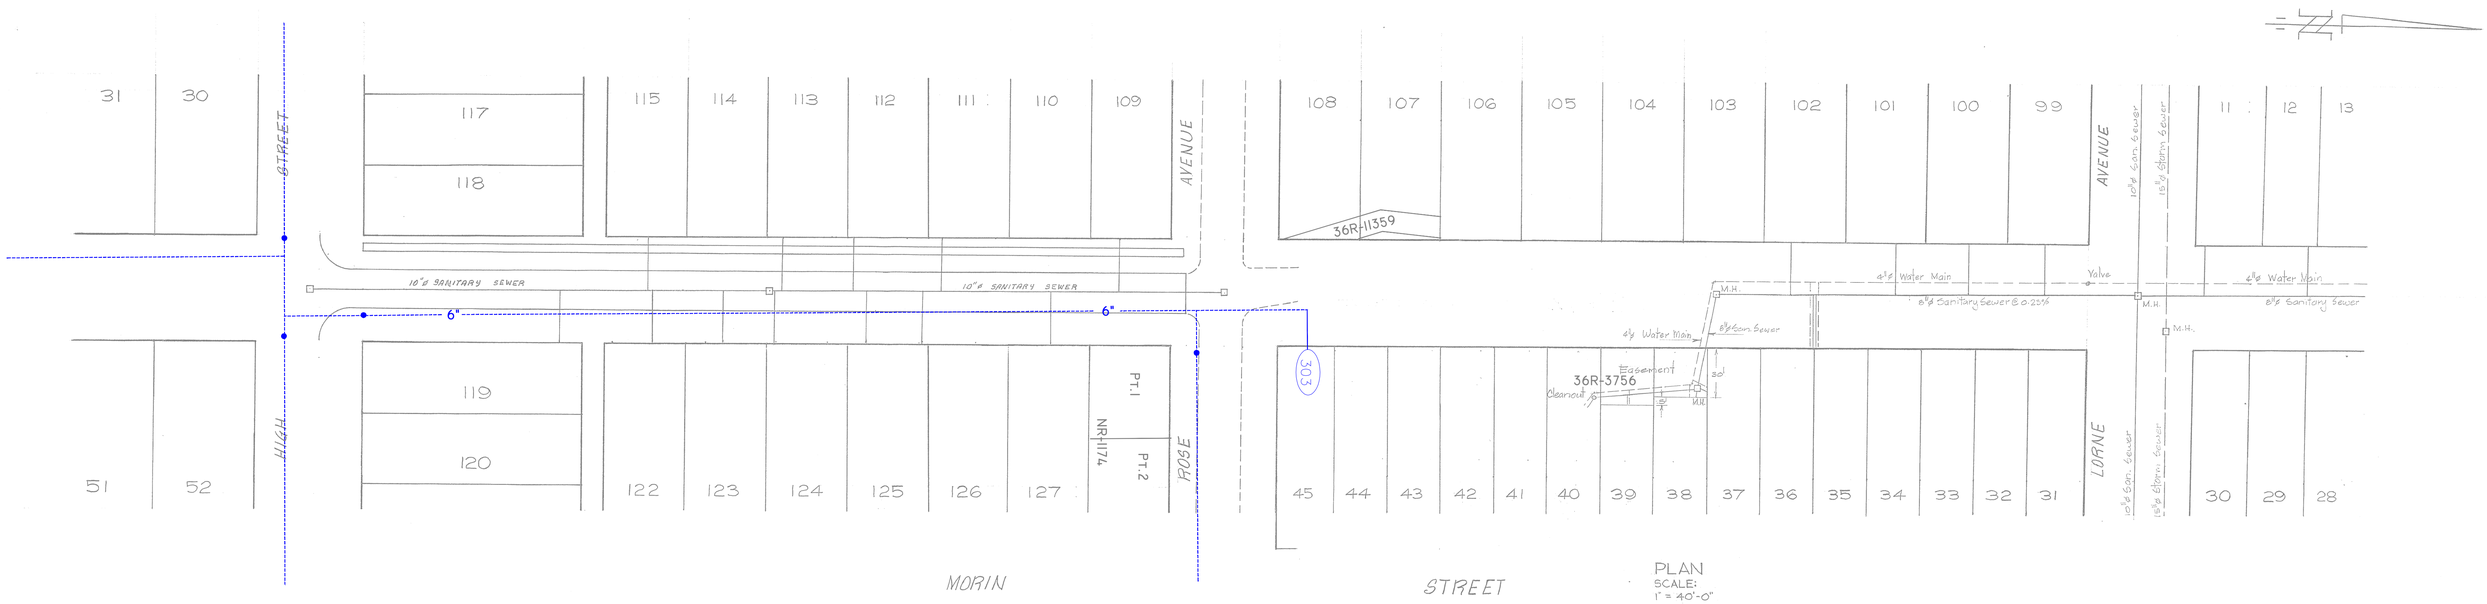

PLAN
SCALE:
1" = 40'-0"

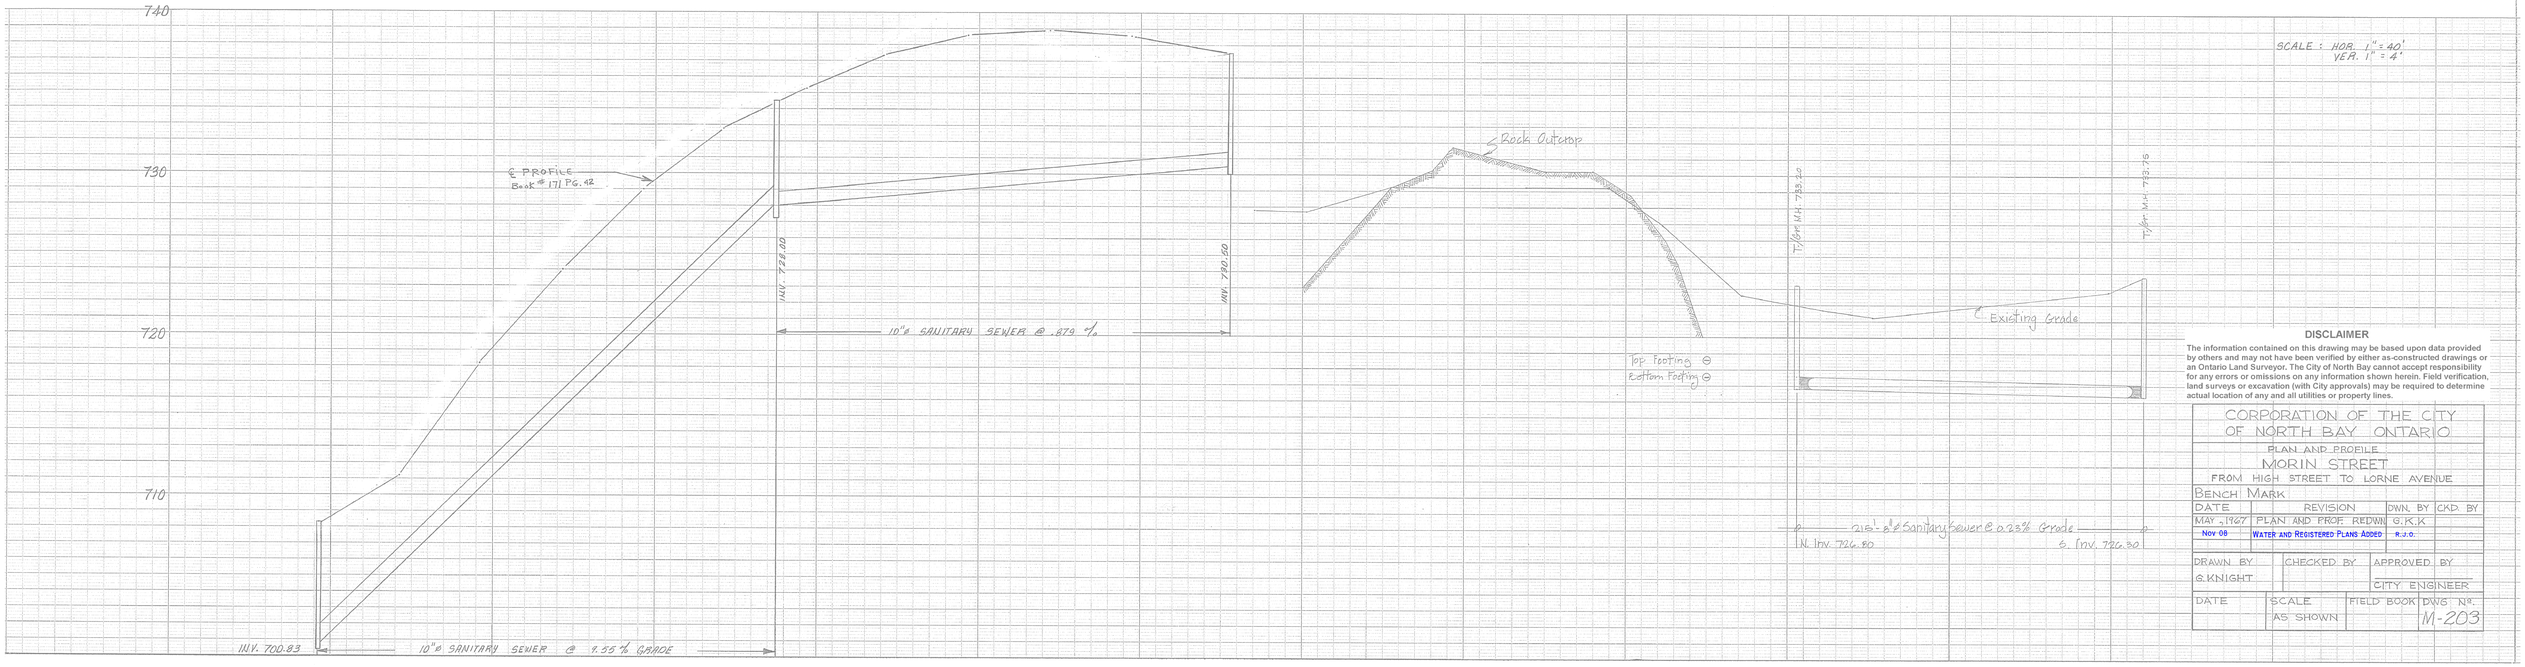

SCALE : HOR. 1" = 40'
VER. 1" = 4'

DISCLAIMER

The information contained on this drawing may be based upon data provided by others and may not have been verified by either as-constructed drawings or an Ontario Land Surveyor. The City of North Bay cannot accept responsibility for any errors or omissions on any information shown herein. Field verification, land surveys or excavation (with City approvals) may be required to determine actual location of any and all utilities or property lines.

CORPORATION OF THE CITY OF NORTH BAY ONTARIO

PLAN AND PROFILE

MORIN STREET

FROM HIGH STREET TO LORNE AVENUE

Bench Mark

DATE	REVISION	DWN. BY	CKD. BY
MAY - 1967	PLAN AND PROF. REDWN	G.K.	K
Nov 08	WATER AND REGISTERED PLANS ADDED	R.J.O.	

DRAWN BY	CHECKED BY	APPROVED BY
G.KNIGHT		CITY ENGINEER

DATE	SCALE	FIELD BOOK	DWG Nº
	AS SHOWN		M-203

DARD MARK
PAT. OFF.

KEUFFEL & ESSER CO

TRADE STANDARD MARK
REG. U.S. PAT. OFF.

TRADE STANDARD MARK