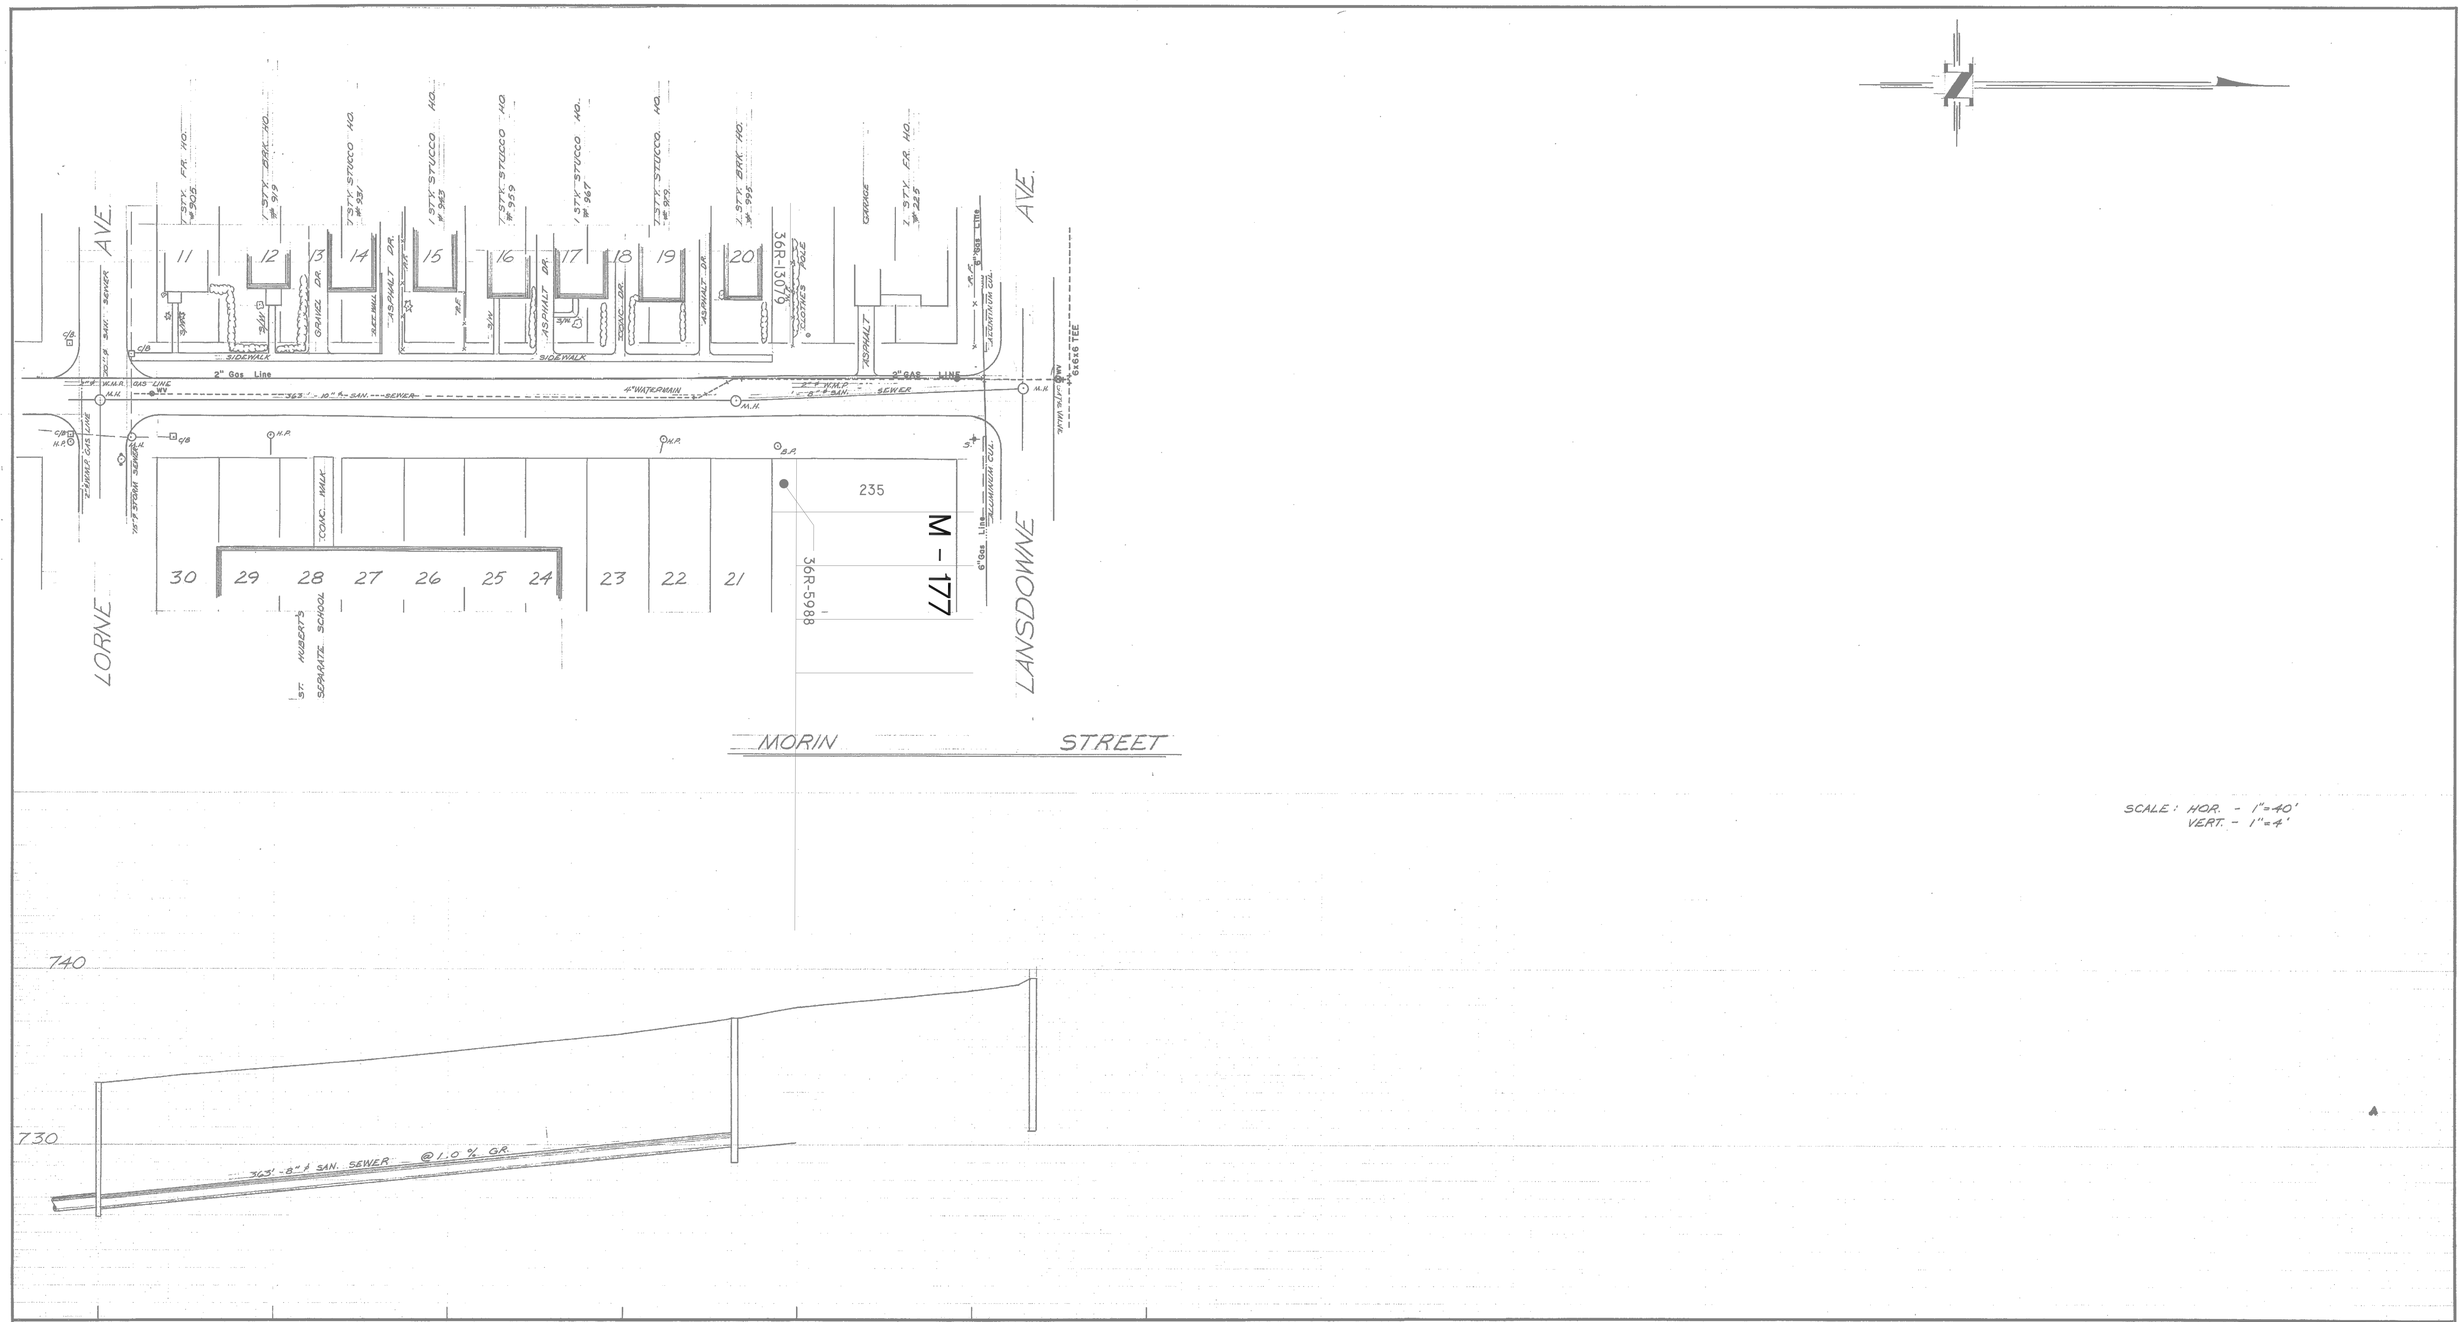

NOTES:

DISCLAIMER

The information contained on this drawing may be based upon data provided by others and may not have been verified by either as-constructed drawings or an Ontario Land Surveyor. The City of North Bay cannot accept responsibility for any errors or omissions on any information shown herein. Field verification, land surveys or excavation (with City approvals) may be required to determine actual location of any and all utilities or property lines.

No.	REVISION	DATE	INITIAL
1.	4" WATERMAIN	AUG/73	GDR
2.	Gas Line, LORNE TO LANSDOWN.	DEC. 75	A.P.

APPROVED

MORIN STREET

0+00 = ℄ OF MORIN ST & LORNE AVE.
CHAINAGE NORTHERLY
LORNE AVE TO LANSDOWNE AVE.

CITY OF NORTH BAY
ENGINEERING DEPARTMENT

SCALE: 1"=40' DATE: AUG. 8/69

DRAWN BY: D.SIMMS CK'D. BY: RD. | FIELD BOOK No. 189 | DRAWING No. M-204 | REV.