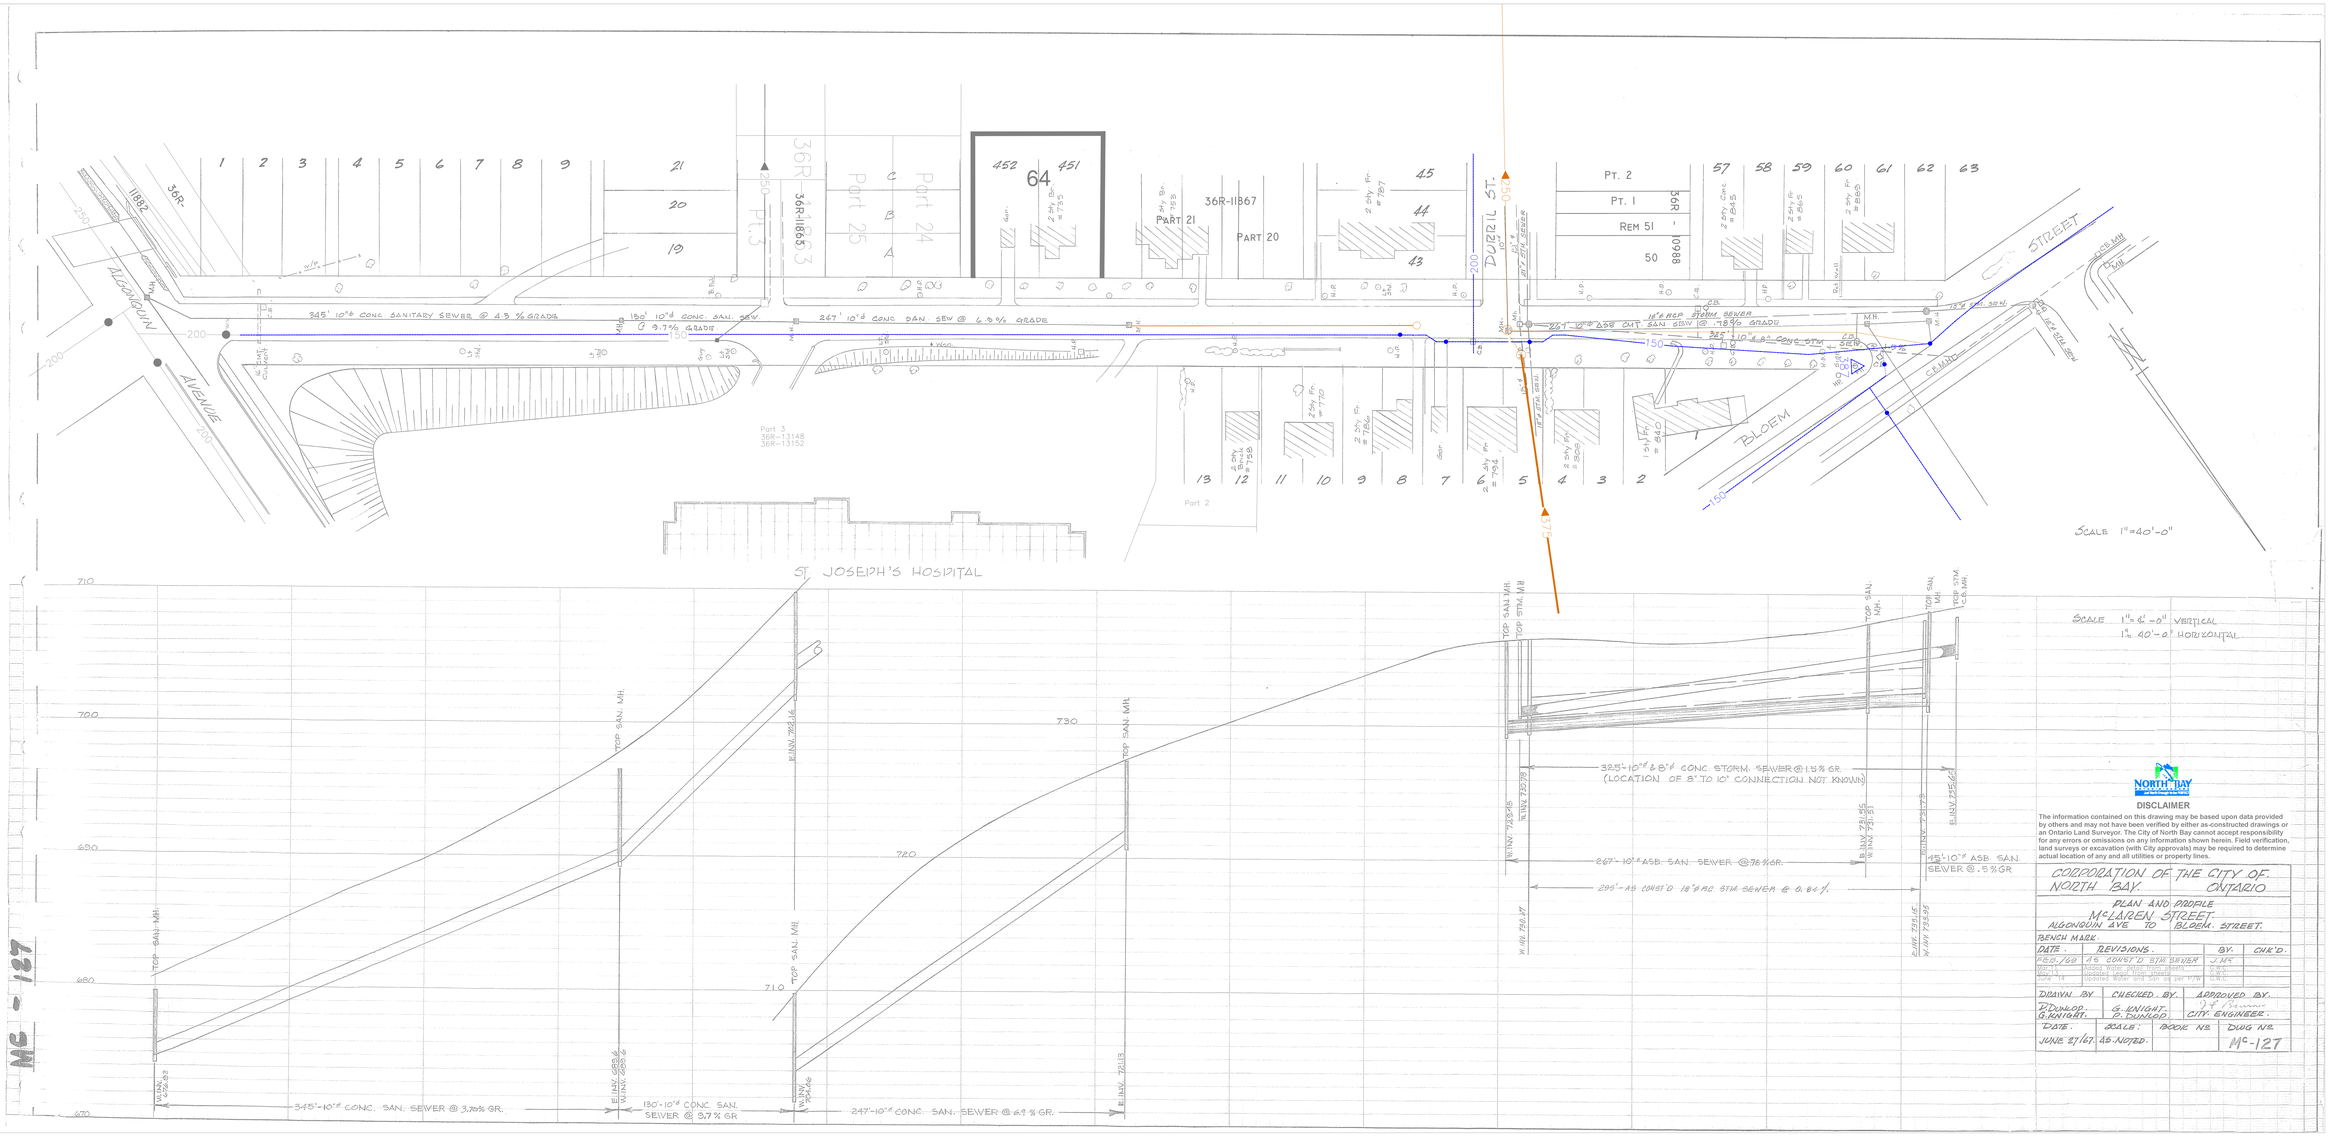

DISCLAIMER

The information contained on this drawing may be based upon data provided by others and may not have been verified by either as-constructed drawings or an Ontario Land Surveyor. The City of North Bay cannot accept responsibility for any errors or omissions on any information shown herein. Field verification, land surveys or excavation (with City approvals) may be required to determine actual location of any and all utilities or property lines.

CORPORATION OF THE CITY OF NORTH BAY. ONTARIO

PLAN AND PROFILE
McLAREN STREET
ALGONQUIN AVE TO BLOEM STREET.

BENCH MARK.

DATE.	REVISIONS.	BY.	CHK'D.
FEB./69	AS CONST'D STM SEWER	J.MC	
MAY 1/	ADDED STORM SEWER FROM PROPERTY	D.W.D.	
MAY 1/	ADDED STORM SEWER FROM PROPERTY	D.W.D.	
JUNE 12	REVISED WORK AND ADD AS BUILT M/H	D.W.D.	

DRAWN BY.	CHECKED BY.	APPROVED BY.
R.DUNLOP. G.KNIGHT.	G. KNIGHT. R.DUNLOP.	CITY ENGINEER.

DATE.	SCALE.	BOOK NO	DWG NO
JUNE 27/67.	AS NOTED.		MC-127