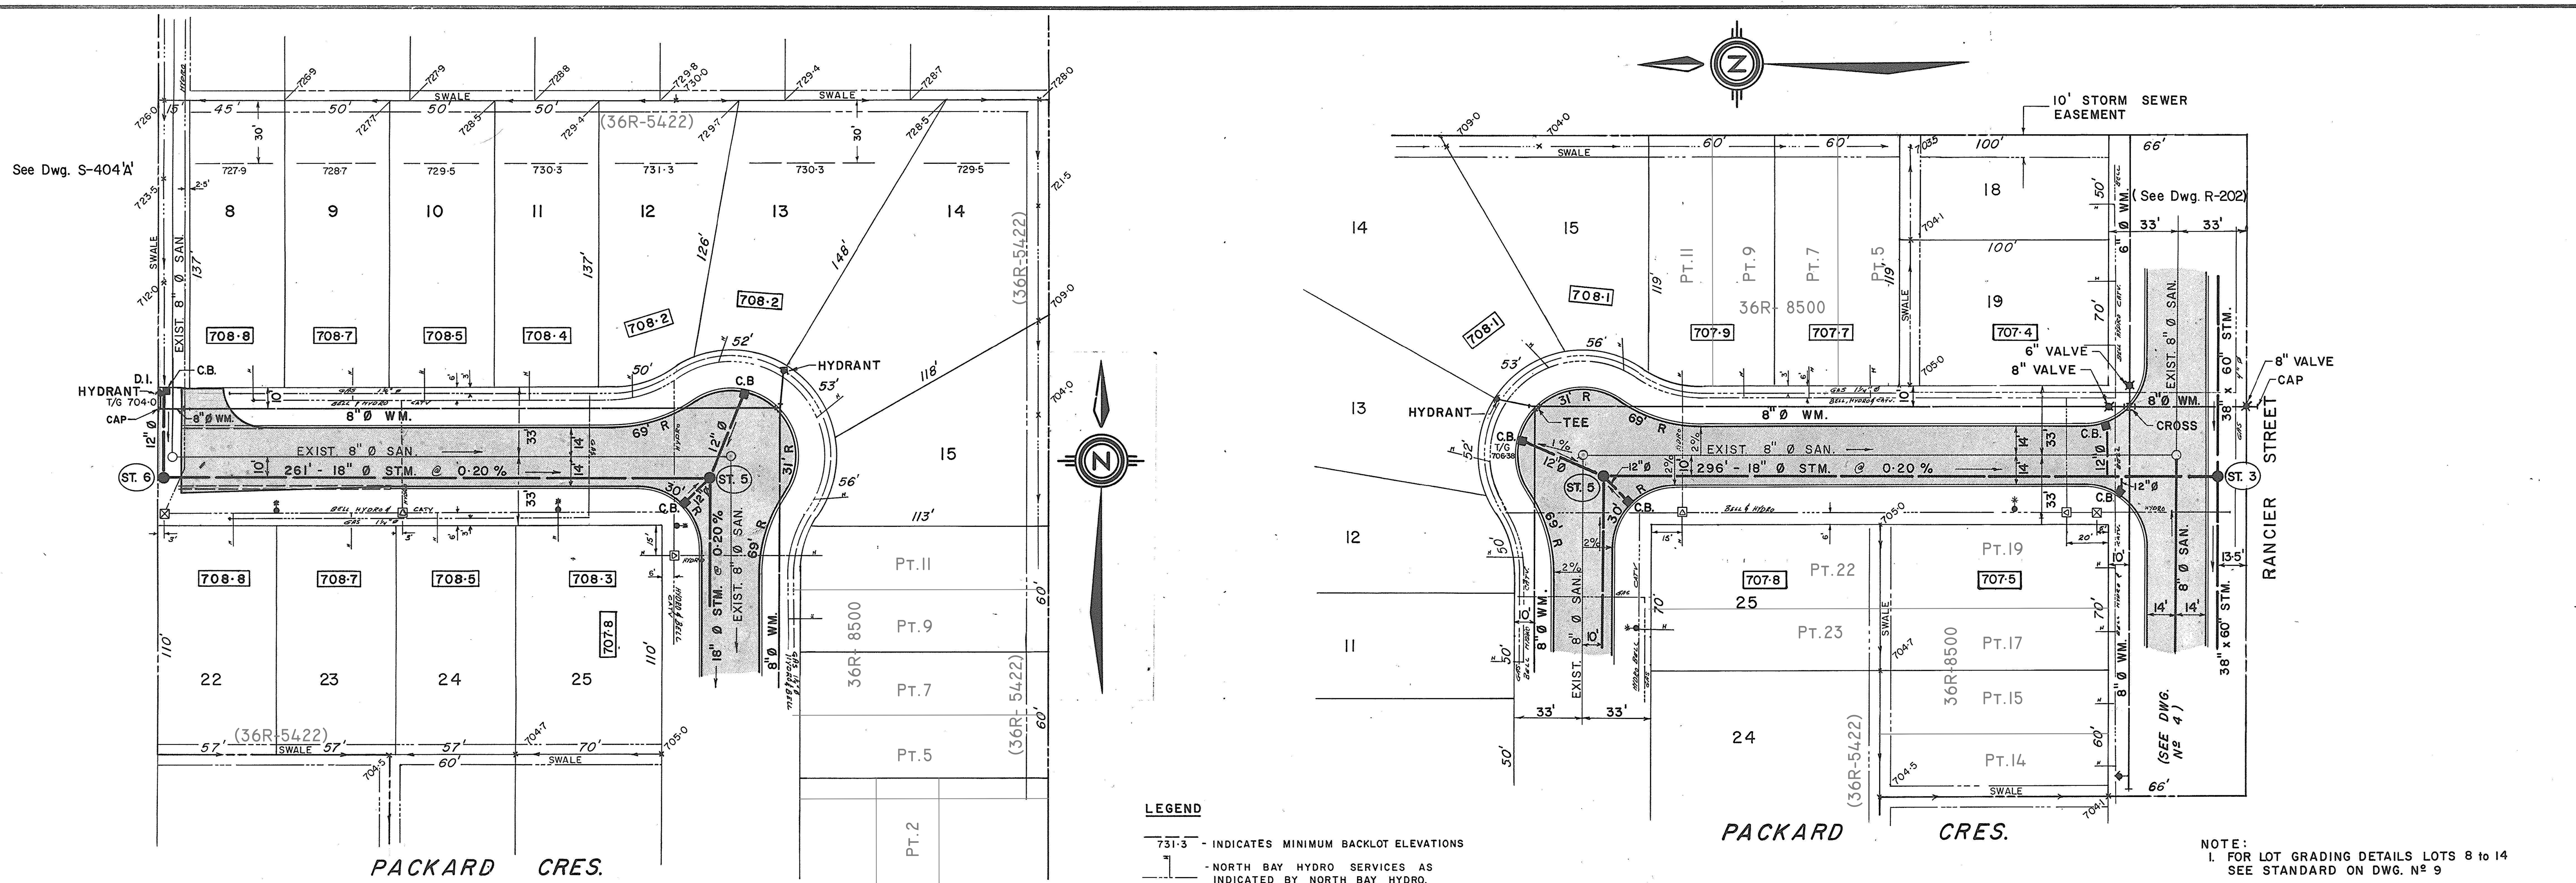

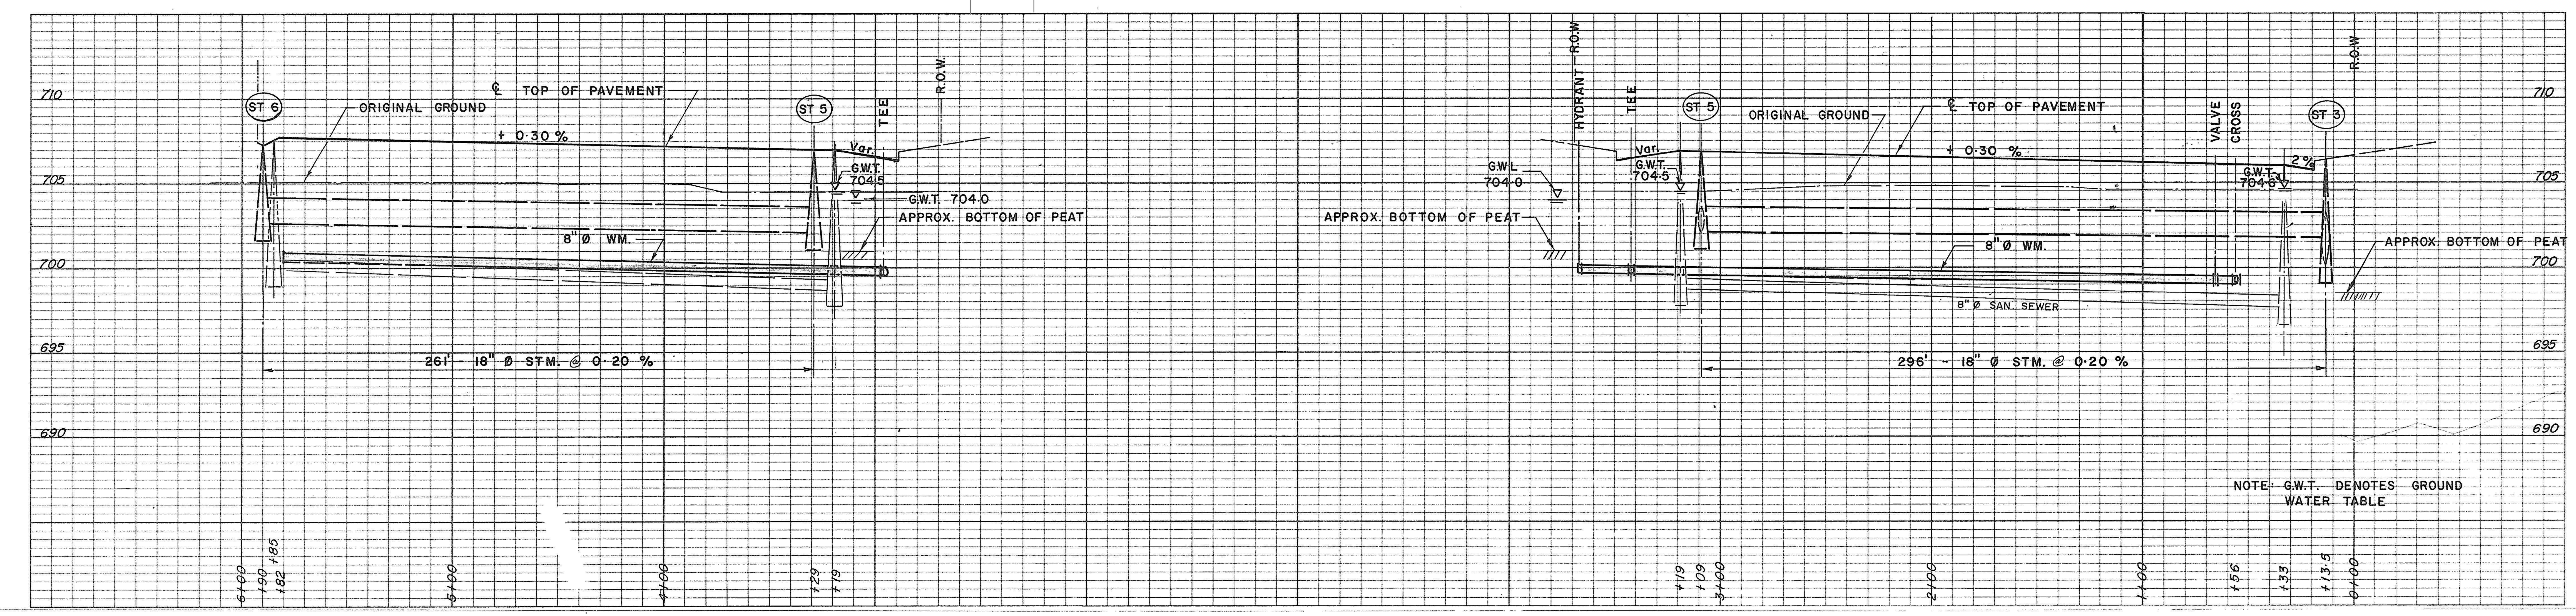

	ST 6	ST 5	ST 5	ST 3	
℄ RD.	707·79	707·00	707·00	706·14	℄ RD.
ELEV. TOP STM. M.H.	707·31	706·72	706·72	706·47	ELEV. TOP STM. M.H.
STM. INV.	702·54	S&W-702·02	S&W-702·02	N- 701·43 / E&W-700·10	STM. INV.
SAN. INV.	699·92	698·79	698.79	697·58/697·44	SAN. INV.

DISCLAIMER

The information contained on this drawing may be based upon data provided by others and may not have been verified by either as-constructed drawings or an Ontario Land Surveyor. The City of North Bay cannot accept responsibility for any errors or omissions on any information shown herein. Field verification, land surveys or excavation (with City approvals) may be required to determine actual location of any and all utilities or property lines.

CATV PLANT APPROVED	GAS PLANT APPROVED
[signature] Date — McLEAN - HUNTER CABLE T.V. Ltd.	R. Henderson Sept 21/79 — Northern & Central Gas Corp. Ltd. Date
HYDRO PLANT APPROVED	**BELL PLANT APPROVED**
[signature] 79-09-21 — North Bay Hydro Date	G. S. Stone 1979 09 21 — Bell Canada Ltd. Date

MK.	BY	REVISIONS	APP.	DATE
	R.J.O.	REGISTERED PLANS ADDED.		JAN 09
	S.C.P	D.I.C.B ON EASEMENT BETWEEN LOTS 17.18.19 HAS BEEN DELECTED	B.D	MARCH 14/80
	S.V.S	GROUND WATER TABLE ADDED AS PER SOIL INVESTIGATION	B.D.	OCT. 2/79
	S.V.S	6"Ø WATERMAIN INCREASED TO 8"Ø ON PACKARD CRES.	B.D.	SEPT. 17/79
	S.V.S	HYDRANT WEST END OF PACKARD CRESCENT	B.D.	SEPT. 14/79

DWN. BY	P. L. C.
CHKD. BY	D. A. R.
DATE	JULY, 1979
SCALE	HORIZONTAL 1"=40' VERTICAL 1"=5'

HILLVIEW PARK SUBDIVISION
STAGE II – PHASE II
MILLFORD DEVELOPMENT LTD.

PACKARD CRESCENT PLAN & PROFILE

Northland Engineering Ltd.
CONSULTING CIVIL ENGINEERS
NORTH BAY - SUDBURY - TORONTO

No. 1206

P-551