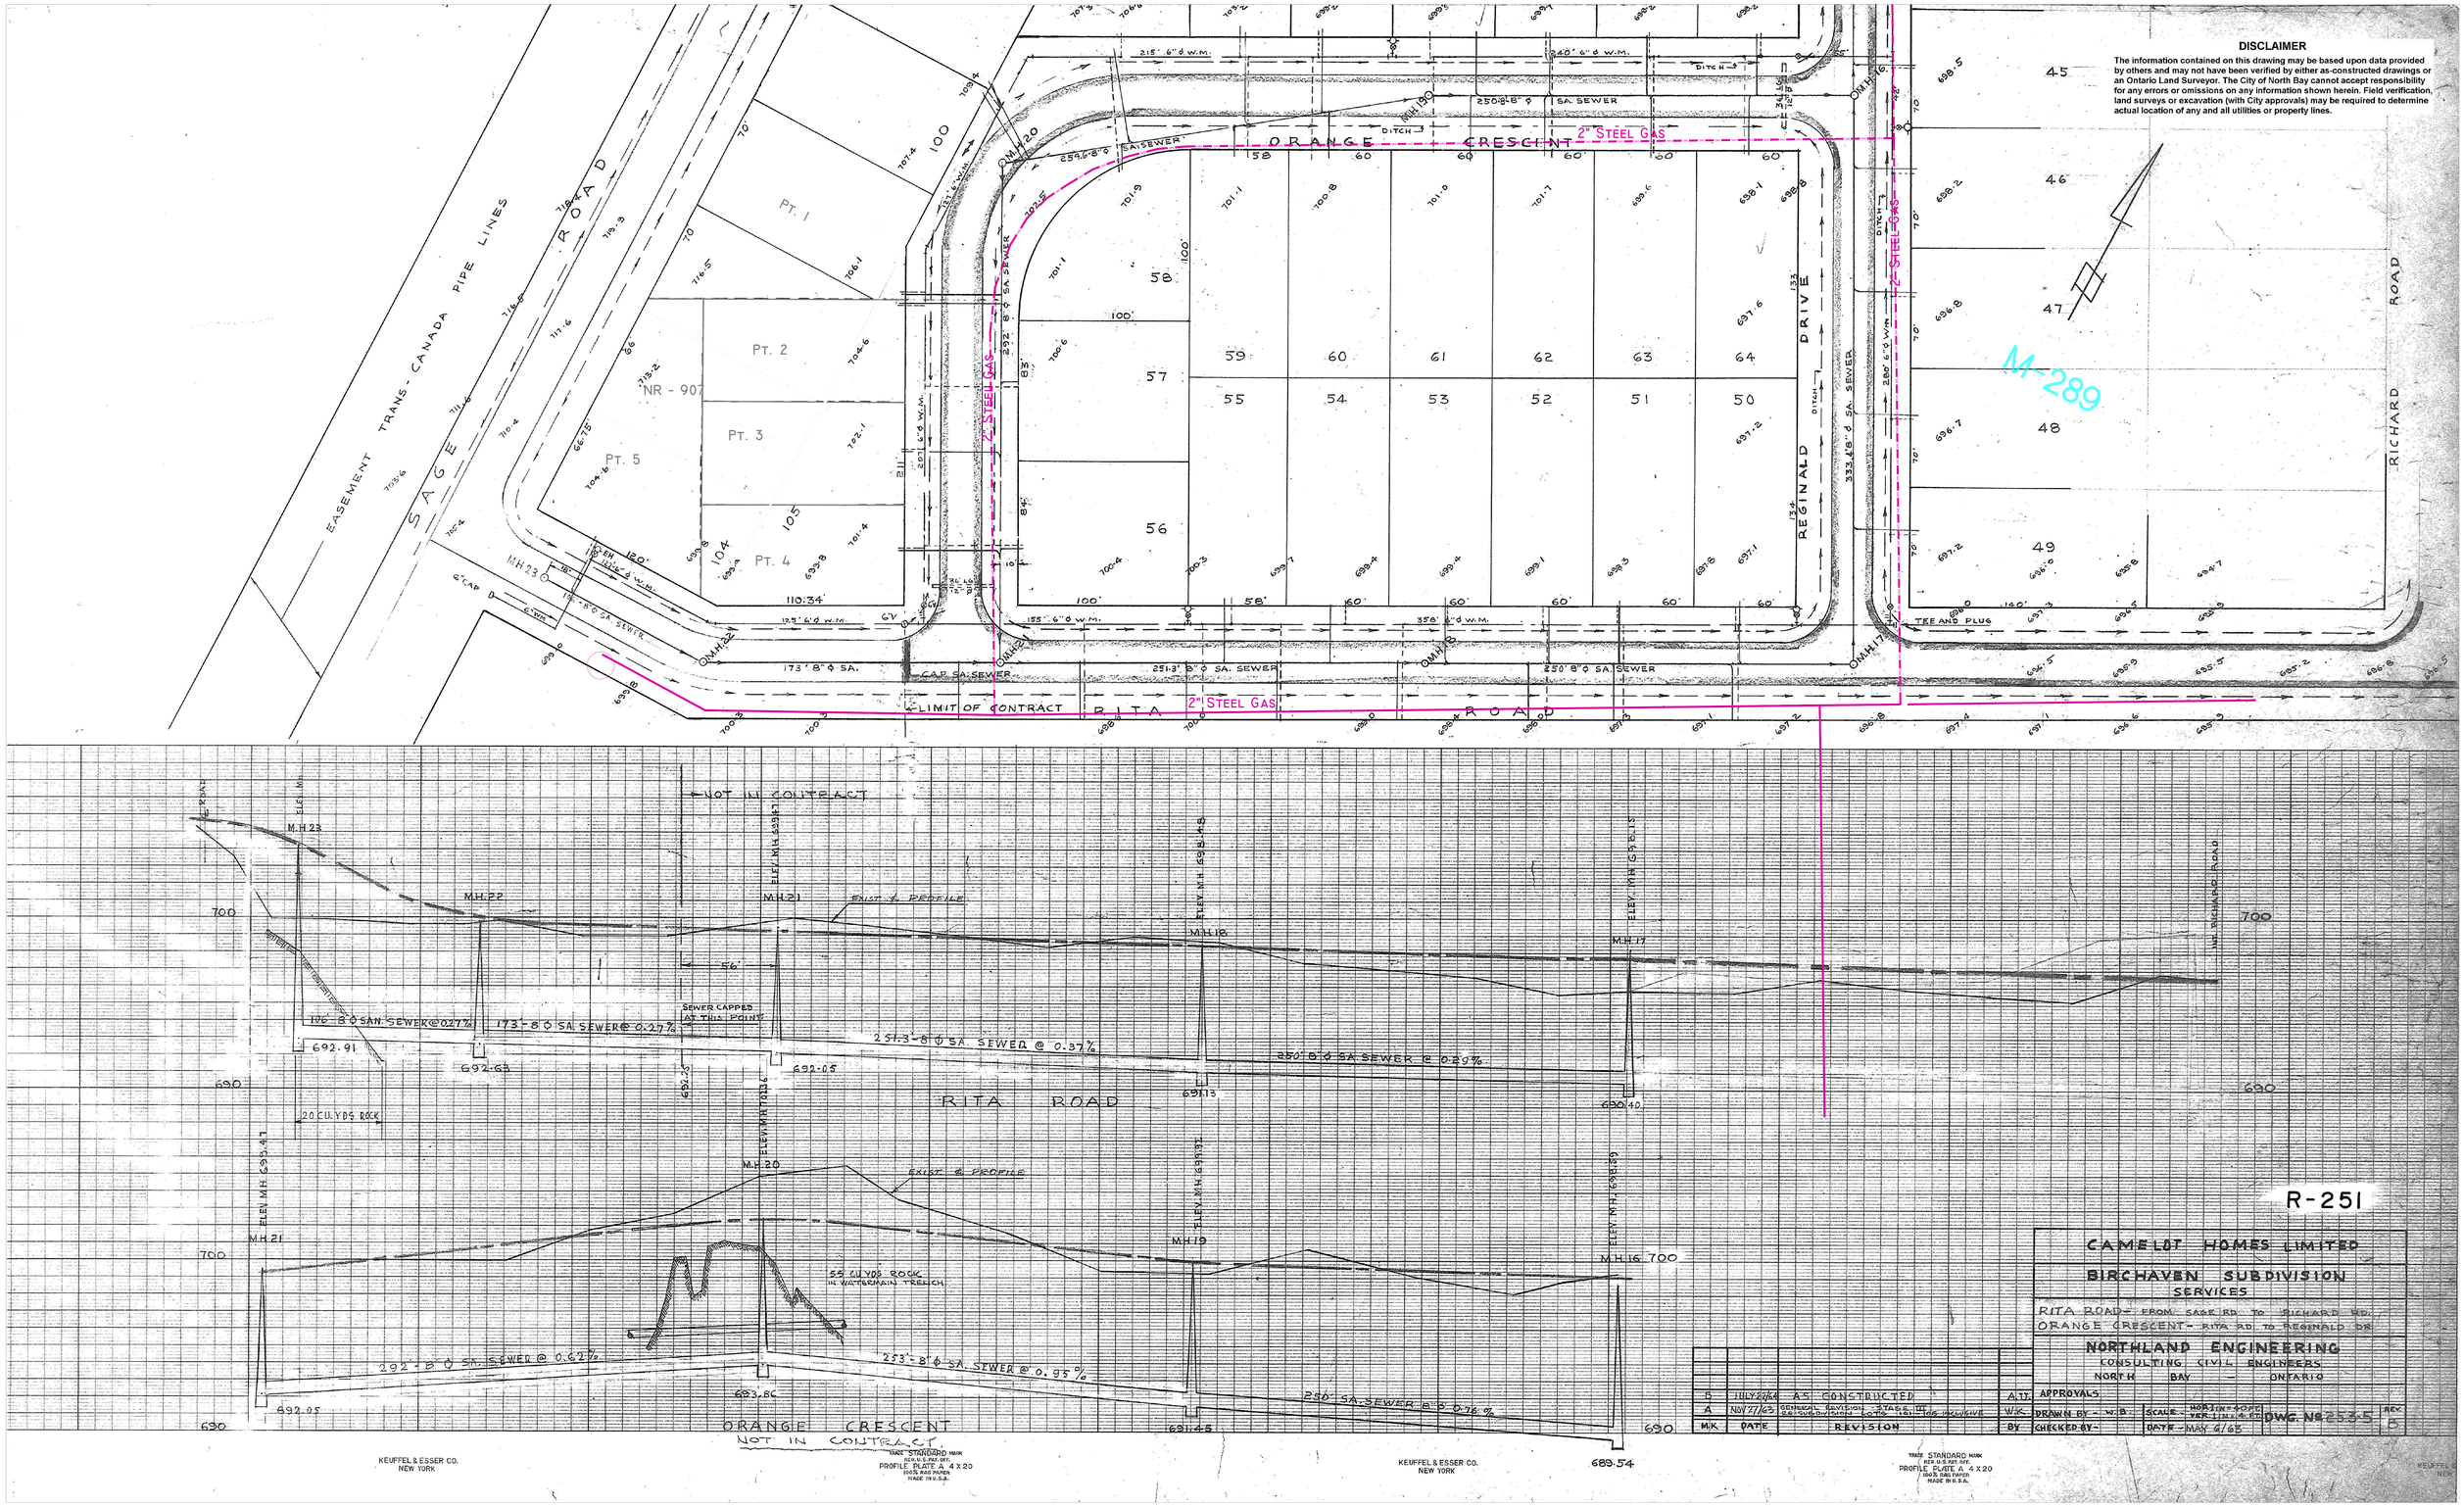

DISCLAIMER

The information contained on this drawing may be based upon data provided by others and may not have been verified by either as-constructed drawings or an Ontario Land Surveyor. The City of North Bay cannot accept responsibility for any errors or omissions on any information shown herein. Field verification, land surveys or excavation (with City approvals) may be required to determine actual location of any and all utilities or property lines.

CAMELOT HOMES LIMITED

BIRCHAVEN SUBDIVISION

SERVICES

RITA ROAD - FROM SAGE RD. TO RICHARD RD.

ORANGE CRESCENT - RITA RD. TO REGINALD DR.

NORTHLAND ENGINEERING

CONSULTING CIVIL ENGINEERS

NORTH BAY - ONTARIO

M.K.	DATE	REVISION	BY
B	JULY 27/66	AS CONSTRUCTED	A.J.
A	NOV 27/63	GENERAL REVISION STAGE III 26 SUBDIVISION LOTS 101-105 INCLUSIVE	W.K.

APPROVALS

DRAWN BY - W.B. SCALE - HORIZ. IN = 40 FT. VER. IN = 4 FT. DWG. No 253-5 REV. B

CHECKED BY - DATE - MAY 6/65

KEUFFEL & ESSER CO. NEW YORK

TRADE STANDARD MARK REG. U.S. PAT. OFF. PROFILE PLATE A 4 X 20 100% RAG PAPER MADE IN U.S.A.