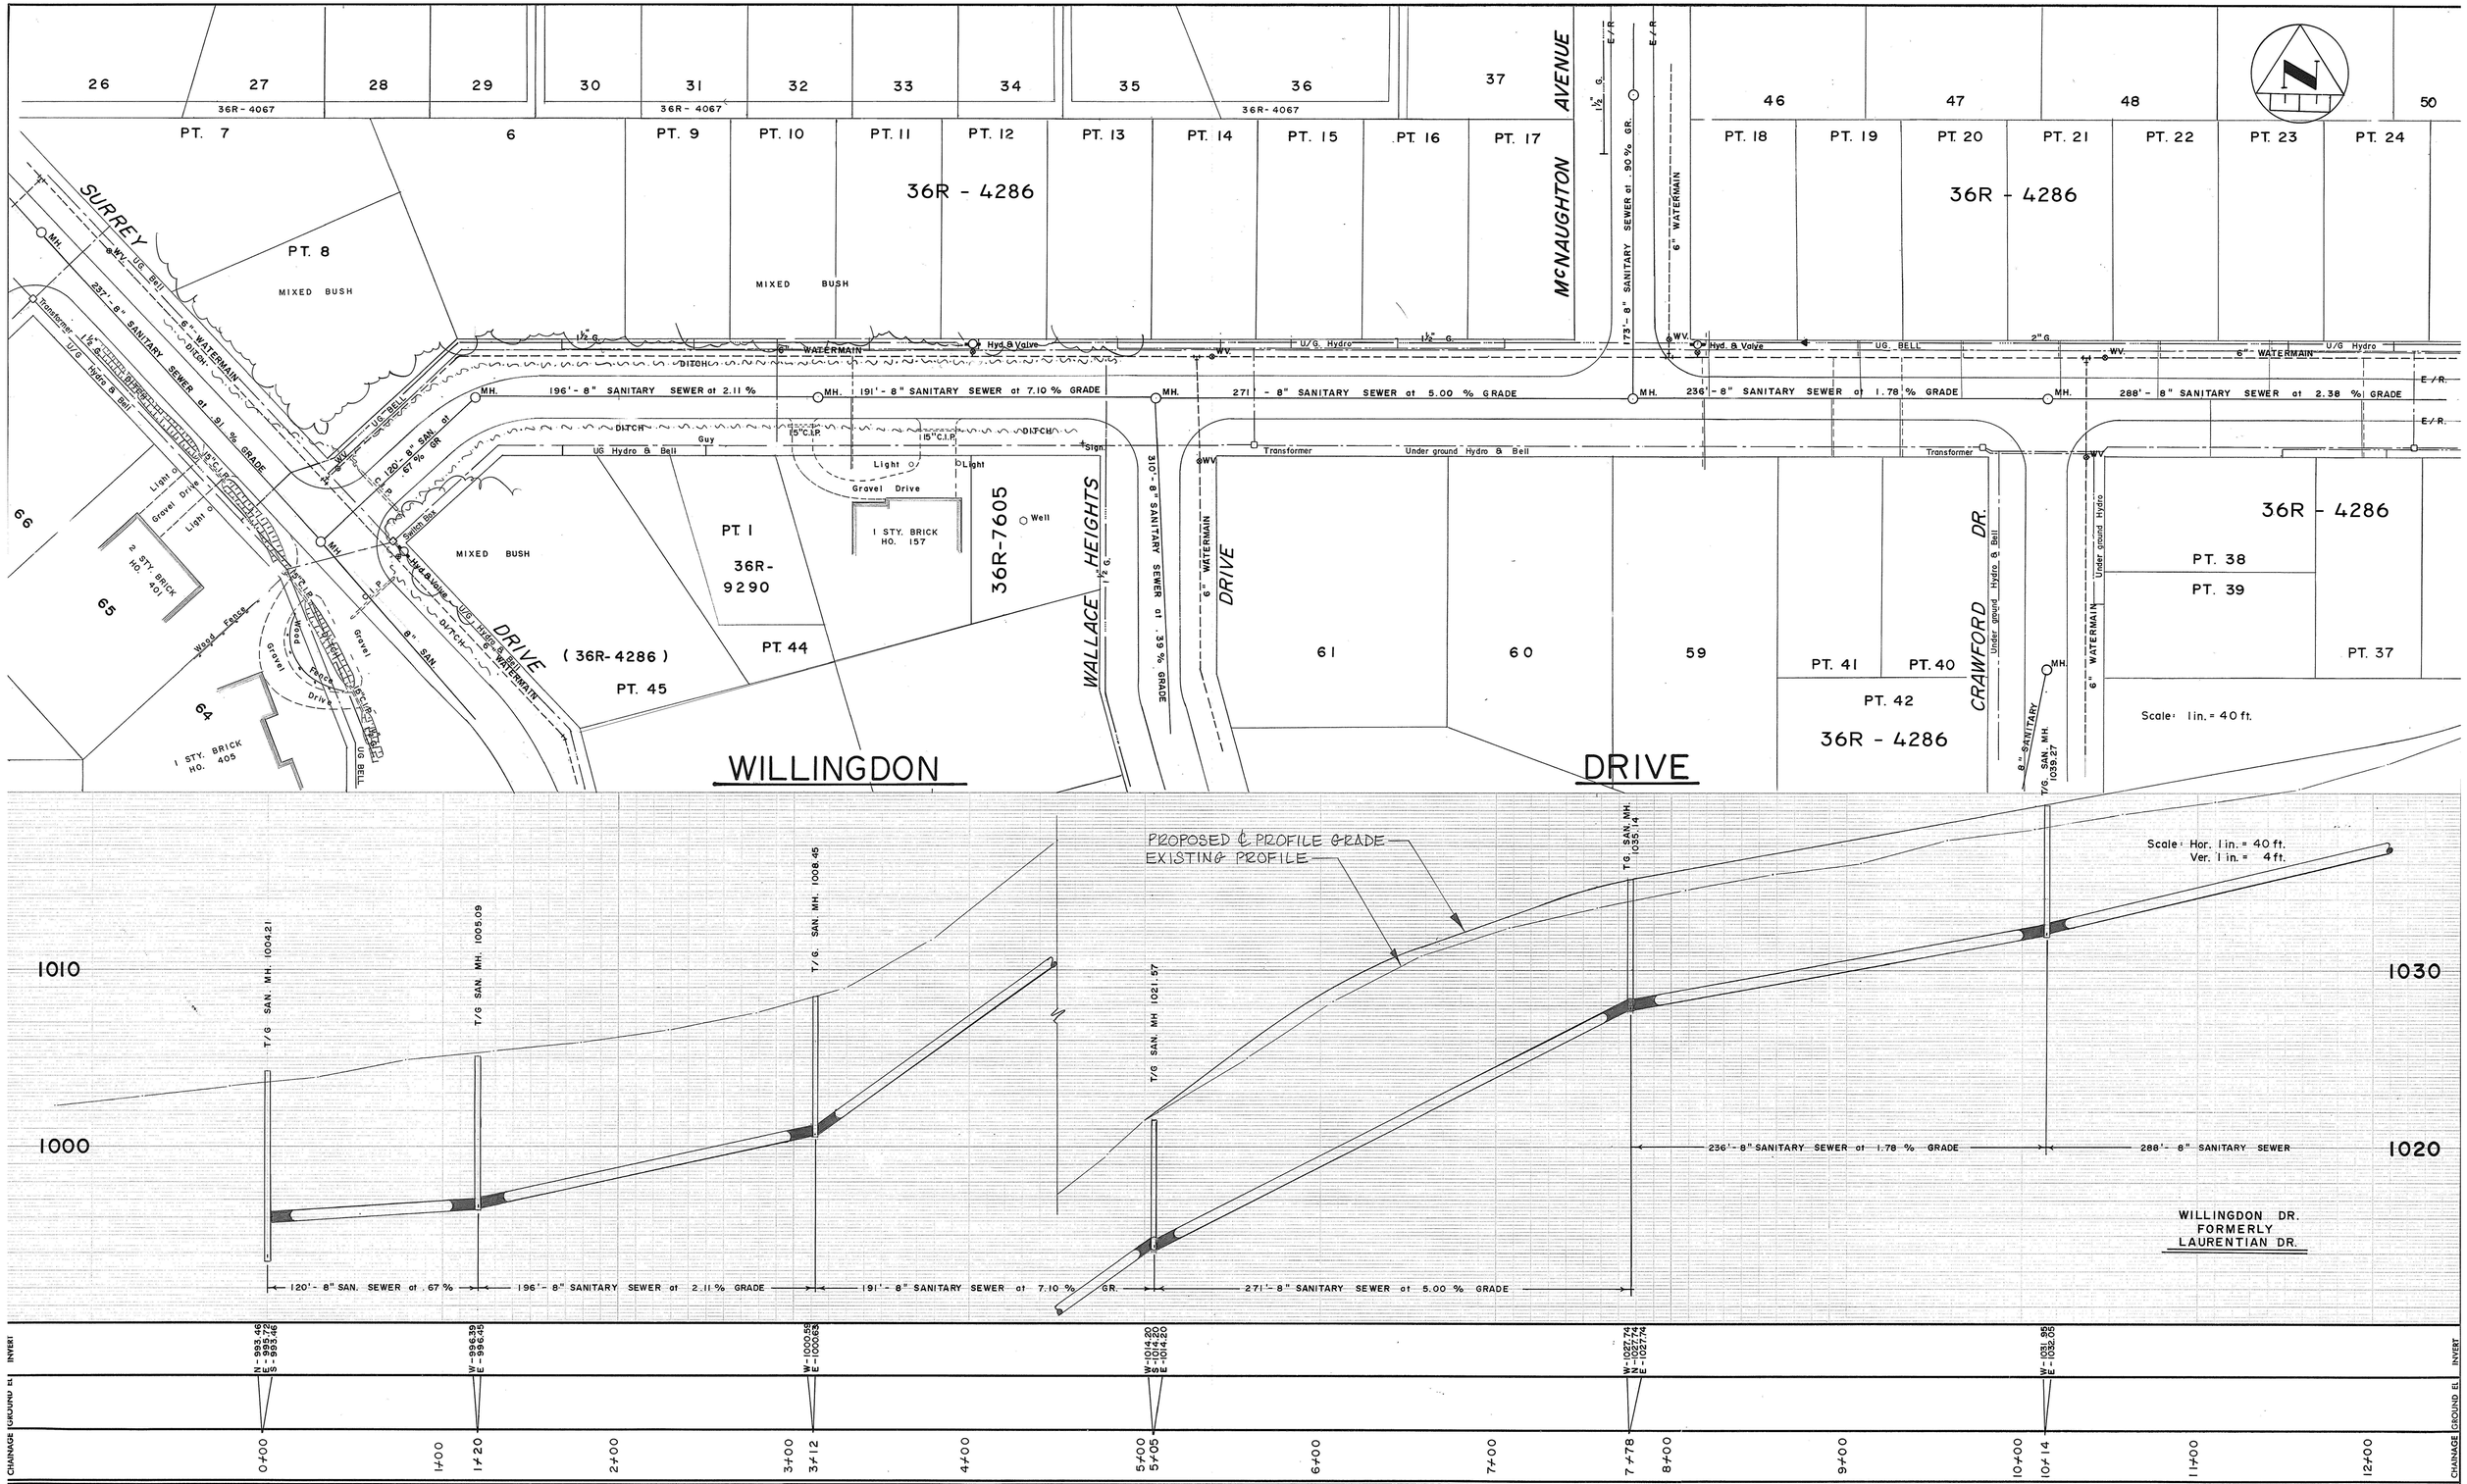

NOTES:

DISCLAIMER

The information contained on this drawing may be based upon data provided by others and may not have been verified by either as-constructed drawings or an Ontario Land Surveyor. The City of North Bay cannot accept responsibility for any errors or omissions on any information shown herein. Field verification, land surveys or excavation (with City approvals) may be required to determine actual location of any and all utilities or property lines.

DWG. NO.

No.	REVISION	DATE	INITIAL
2.	AS CONS'T. SAN. & WATERMAIN	Feb / 77	j.d.m.
3.	REVISED STREET NAME.	JUNE/ 78	j.d.m.
4.	UNDER GROUND HYDRO & BELL CABLE	JUNE/ 78	j.d.m.

APPROVED

WILLINGDON DRIVE

SURREY DRIVE TO STA. 12+00

REG'D PLAN M-312 36R-4286

CITY OF NORTH BAY

ENGINEERING DEPARTMENT

SCALE: AS SHOWN

DATE: JAN 1975

DRAWN BY: B. D.

CK'D. BY:

FIELD BOOK No. 191, 246

DRAWING No. W-126

REV.